

MISSISSIPPI DEPARTMENT OF NATURAL RESOURCES

Bureau of Land and Water Resources

Southport Mall

P.O. Box 10631

Jackson, Mississippi 39209

WATER WELL DRILLERS-LOG

CODED

LEFTORE
E 56

11-24 1985
date well completed

BUTANE GAS COMPANY
OF GREENWOOD

Leftore
county well located

LANDOWNER: Dr. Mike Coleman
B. Money Mo.
(mailing address)


WELL LOCATION:
sec. 19 T. 210 N. R. 10 E.
2 miles NW of MONEY
(distance) (direction) (nearest town)

WELL PURPOSE:
(home) irrigation, municipal, industrial

WELL COMPLETION DATA:
(1) diameter (inches) 3" x 4"
(2) total depth (feet) 822
(3) static water level (feet) 1 below top of ground. above
(4) casing Steel 651'-3" (material) 126' 4" (depth)
3" x 4" (size) if telescope see back.
(5) screen 30' 777' (length) (depth to top)
3" Steel (size) (material)
(6) pump 3 60 (HP) (yield gpm)
Elect. (type power)
(7) electric log No (yes or no)
No (organization running log)
(8) how well bottom plugged
Back with Valve

description of formations encountered	from	to
CLAY	0	10
SAND	10	85
gravel	85	110
CLAY	110	190
SAND	190	265
CLAY	265	280
Shale + rk st.	280	362
Rock	362	420
chale SAND ROCK	420	445
Shale Rock	445	480
isand shale	480	560
shale	560	610
hard shale	610	645
SANDY shale	645	670
hard shale	670	740
fine sand shale	740	785
fine SAND	785	820
white sand	820	822
sand shale st.		

CODED

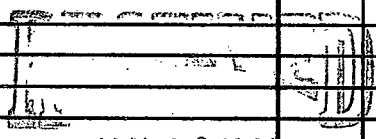


JAN 08 1986

Department of Natural Resources
Bureau of Land & Water Resources

DRILLERS REMARKS:
Richard Vest

If well telescopes please sketch and show depths.

GROUND LEVEL

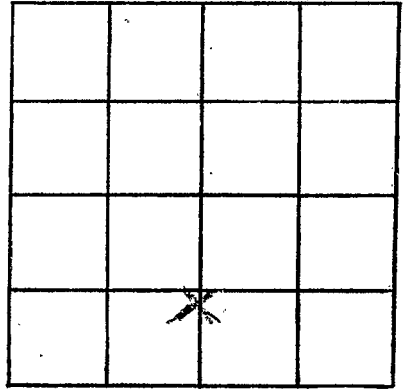

SECTION 14

Please indicate well location X.

ADDITIONAL INFORMATION

If more than one screen,
show locations of each on sketch.