

MISSISSIPPI DEPARTMENT OF NATURAL RESOURCES

Bureau of Land and Water Resources

Southport Mall

P.O. Box 10631

Jackson, Mississippi 39209

WATER WELL DRILLERS LOG

CODED

LeFlotte  
E 57  
FW 6309

5-1 <sup>1987</sup> BUTANE GAS CO. OF GREENWOOD LeFlotte  
 date well completed firm name county well located

LANDOWNER:	description of formations encountered	from	to
<u>Harold Smith</u>			
<u>Box 1079 - Greenwood</u> (mailing address)	<u>FINE SAND</u>	<u>.5</u>	<u>5.5</u>
WELL LOCATION:	<u>SAND &amp; PEA GRAVEL</u>	<u>5.5</u>	<u>8.5</u>
sec. <u>10</u> T. <u>21</u> N. R. <u>1</u> E. S. <u>5</u> WP	<u>ROCK</u>	<u>8.5</u>	
<u>3</u> miles <u>E</u> of <u>Ruby</u> (distance) (direction) (nearest town)			
WELL PURPOSE: <u>wildlife</u> (home, irrigation, municipal, industrial)			
WELL COMPLETION DATA:			
(1) diameter (inches) <u>16</u>			
(2) total depth (feet) <u>85</u>			
(3) static water level (feet) <u>18</u> below above top of ground.			
(4) casing <u>Steel</u> , <u>45</u> (material) (depth)			
<u>16</u> if telescope see back. (size)			
(5) screen <u>40</u> , <u>45</u> (length) (depth to top)			
<u>16"</u> , <u>Steel</u> (size) (material)			
(6) pump <u>60</u> <u>2500</u> (HP) (yield gpm)			
<u>Diesel</u> (type power)			
(7) electric log <u>NO</u> (yes or no)			
(organization running log)			
(8) how well bottom plugged <u>Steel Plate</u>			
DRILLERS REMARKS:			

CODED

RECEIVED


MAY 28 1987

Department of Natural Resources  
 Bureau of Land & Water Resources

24

If well telescopes please sketch and show depths.

GROUND LEVEL

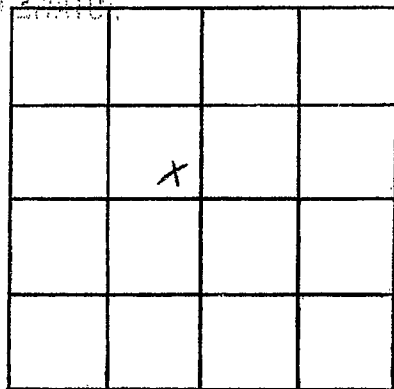

SECTION 10

Please indicate well location X.

ADDITIONAL INFORMATION

If more than one screen,  
show locations of each on sketch.