

MISSISSIPPI DEPARTMENT OF NATURAL RESOURCES

Bureau of Land and Water Resources

Southport Mall

P.O. Box 10631

Jackson, Mississippi 39209

WATER WELL DRILLERS LOG

BUTANE GAS COMPANY

OF GREENWOOD

LEFLORE
E 72
GW 112
5124184

NUN
Replaced by
GW 41887

CODE

Leflore
county well located

5-24 1984
date well completed

LANDOWNER:
Dr. Michael Coleman
Greenwood (Schlaty)
(mailing address)

description of formations encountered	from	to
	<u>Clay</u>	<u>0</u>
<u>Sand</u>	<u>12</u>	<u>55</u>
<u>Sand per gravel</u>	<u>55</u>	<u>70</u>
<u>gravel</u>	<u>70</u>	<u>95</u>
<u>Rock</u>	<u>95</u>	

WELL LOCATION:
sec. 30 T 21 N R 1 E
S W
2 miles NW of Money
(distance) (direction) (nearest town)

WELL PURPOSE: Drain
(home, irrigation, municipal, industrial)

CODED

- WELL COMPLETION DATA:
- (1) diameter (inches) 16"
 - (2) total depth (feet) 95'
 - (3) static water level (feet) 20 below above top of ground.
 - (4) casing Steel 55'
(material) (depth)
 - 16" if telescope see back.
(size)
 - (5) screen 40' 55'
(length) (depth to top)
 - 16" Steel
(size) (material)
 - (6) pump 60 1400
(HP) (yield gpm)
 - Diesel
(type power)
 - (7) electric log No
(yes or no)
No
(organization running log)
 - (8) how well bottom plugged Steel plate

DEPT. OF NATURAL RESOURCES
BUREAU OF LAND & WATER RESOURCES


JUN 18 1984

RECEIVED

DRILLERS REMARKS:
Richard

If well telescopes please sketch and show depths.

GROUND LEVEL

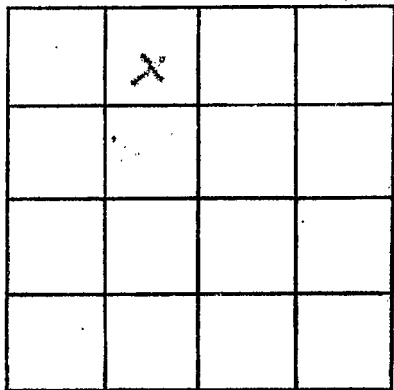

SECTION 30

Please indicate well location X.

ADDITIONAL INFORMATION

If more than one screen,
show locations of each on sketch.