

MISSISSIPPI DEPARTMENT OF NATURAL RESOURCES

Bureau of Land and Water Resources

Southport Mall

P.O. Box 10631

Jackson, Mississippi 39209

WATER WELL DRILLERS LOG

LEFLORE
E 73
SW 110

CODEL

Leflore
county well located

5-29 1984
date well completed

BUTANE GAS COMPANY
OF GREENWOOD

LANDOWNER:	description of formations encountered	from	to
<i>Dr. Michael Coleman</i>	CLAY	0	10
<i>Greenwood - Schlater</i> (mailing address)	SAND	10	45
	SAND p-gravel	45	60
	gravel	60	125
WELL LOCATION:			
sec. <u>30</u> T. <u>20</u> N. R. <u>10</u> E. S. W.			
<u>2.4</u> miles <u>NW</u> of <u>Money</u> (distance) (direction) (nearest town)			
WELL PURPOSE: <u>irrigation</u> (home, irrigation, municipal, industrial)			
WELL COMPLETION DATA:			
(1) diameter (inches) <u>16"</u>			
(2) total depth (feet) <u>125'</u>			
(3) static water level (feet) <u>20</u> below top of ground.			
(4) casing <u>Steel</u> , <u>15'</u> (material) (depth) <u>16"</u> (size) if telescope see back.			
(5) screen <u>40'</u> , <u>65'</u> (length) (depth to top)			
<u>16"</u> , <u>Steel</u> (size) (material)			
(6) pump <u>60</u> , <u>1400</u> (HP) (yield gpm) <u>Recirc</u> (type power)			
(7) electric log <u>No</u> (yes or no) <u>AS</u> (organization running log)			
(8) how well bottom plugged <u>Steel plate</u>			
DRILLERS REMARKS: <u>Richard V.</u>			

CODEL


DEPT. OF NATURAL RESOURCES
BUREAU OF LAND & WATER RESOURCES

JUN 18 1984

RECEIVED

If well telescopes please sketch and show depths.

GROUND LEVEL

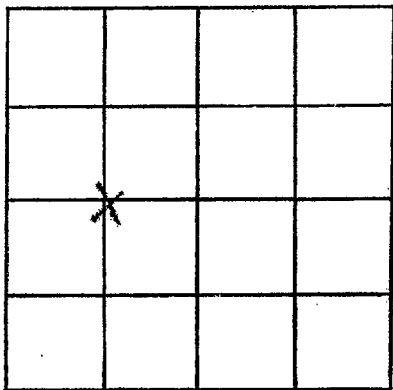

SECTION 30

Please indicate well location X.

ADDITIONAL INFORMATION

If more than one screen,
show locations of each on sketch.