

MISSISSIPPI DEPARTMENT OF NATURAL RESOURCES

Bureau of Land and Water Resources

Southport Mall

P.O. Box 10631 CODED

Jackson, Mississippi 39209

WATER WELL DRILLERS LOG

LEFLORE
E-75

GW 6864

5-25 1987 BUTANE GAS CO. OF GREENWOOD LeFlore
date well completed firm name county well located

LANDOWNER:	description of formations encountered	from	to
Rebecca GARY 742 CHAPARRO COVINA, CALIFORNIA (mailing address) 91724			
WELL LOCATION: sec. 33 T 21 N R 1 E 1/2 miles EAST of MONEY (distance) (direction) (nearest town)			
WELL PURPOSE: FRR (home, irrigation, municipal, industrial)			
WELL COMPLETION DATA:			
(1) diameter (inches) 16	Permit #		
(2) total depth (feet) 105			
(3) static water level (feet) 20 below top of ground.	06864-LAR-04-24-87		
(4) casing Steel, 65 (material) (depth) 16" (size) if telescope see back.			
(5) screen 40, 65 (length) (depth to top) 16" (size), Steel (material)			
(6) pump 174, 2550 (HP) (yield gpm) Diesel (type power)			
(7) electric log NO (yes or no) (organization running log)			
(8) how well bottom plugged Steel Plate			

CODED

RECEIVED

JUN 03 1987


Department of Natural Resources
Bureau of Land & Water Resources

DRILLERS REMARKS:

If well telescopes please sketch and show depths.

GROUND LEVEL 50.0

240 2/21/11

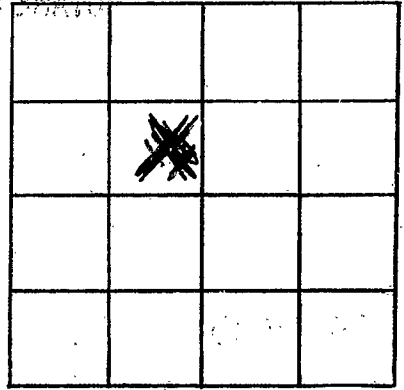

SECTION 2B

Please indicate well location X.

ADDITIONAL INFORMATION

If more than one screen, show locations of each on sketch.