

MISSISSIPPI DEPARTMENT OF NATURAL RESOURCES
 Bureau of Land and Water Resources
 Southport Mall
 P.O. Box 10631
 Jackson, Mississippi 39209
WATER WELL DRILLERS LOG

Buck Ridge Farms
GW. 8053
Coded

LETROUS
E/76
129 A

11-77 date well completed *1987 J B K IRRIGATION* firm name *LeFlore* county well located


LANDOWNER: *HAROLD SMITH*
P.O. Box 1077
Steerwood, miss
 (mailing address)

description of formations encountered	from	to
	<i>Clay</i>	<i>0</i>
<i>Fine SAND</i>	<i>15</i>	<i>32</i>
<i>SAND & GRAVEL</i>	<i>32</i>	<i>107</i>

WELL LOCATION:
 sec. *16* T. *21* N. R. *1* E.
4 miles *NW* of *Money*
 (distance) (direction) (nearest town)

WELL PURPOSE: *Recreation*
 (home, irrigation, municipal, industrial)

- WELL COMPLETION DATA:
- (1) diameter (inches) *10"*
 - (2) total depth (feet) *107*
 - (3) static water level (feet) *17* below top of ground.
 - (4) casing *Pvc* *2967*
 (material) (depth)
10" if telescope see back.
 (size)
 - (5) screen *40* *2967*
 (length) (depth to top)
10" *Pvc*
 (size) (material)
 - (6) pump *15* *900*
 (HP) (yield gpm)
Electric
 (type power)
 - (7) electric log *no*
 (yes or no)
 (organization running log)
 - (8) how well bottom plugged *CAP*

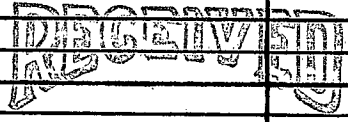


NOV 12 1987

Department of Natural Resources
 Bureau of Land & Water Resources

DRILLERS REMARKS:

If well telescopes please sketch and show depths.

GROUND LEVEL

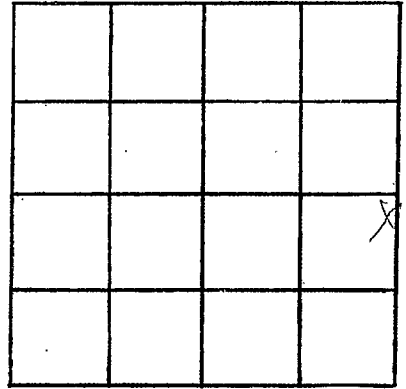

SECTION 10

Please indicate well location X.

ADDITIONAL INFORMATION

If more than one screen,
show locations of each on sketch.