

State Well Report Part 1

County: Leflore
 Permit #: GW42346
 Driller: Irrigation Equipment
 Date drilling completed: 2-25-08

Mississippi Department of Environmental Quality
 Office of Land and Water Resources
 P.O. Box 10631
 Jackson, MS 39289-0631
 (601)961-5210
 (601)354-6938 (fax)

For Office Use Only:

Aquifer: _____
 Well #: E-90
 L. S. Elevation: _____
 E-log #: _____

State Law requires that this report be prepared by the driller in detail and filed with the Department within 30 days of completion of drilling of the well.

Well Owner Information	Well Location
Owner Name: <u>New Hope Farms</u>	Latitude: <u>33° 38' 50.6"</u> Longitude: <u>90° 12' 53.5"</u>
Mailing Address: <u>C/O Wayne Bush</u>	Method of Lat/Long (circle one): <u>50</u> Conventional Survey, <u>53</u>
<u>49665 County Rd 559</u>	USGS quad, Hand-held GPS, Survey-grade GPS
<u>Schlater Ms. 38952</u>	<u>SW</u> 1/4 <u>SE</u> 1/4 Sec <u>29</u> Twn <u>21N</u> Rng <u>1E</u>
City State Zip Code	<u>NW</u> <u>NE</u> <u>32</u>
Telephone No. <u>662 658-1166</u>	Distance Direction Nearest Town
	<u>1</u> Miles <u>W</u> of <u>Maney</u>

Well Data

Purpose of Well (circle one) Home Industrial Public Supply Irrigation Fish Culture Other: _____

Date well drilling started: 2-25-08 Date well drilling completed: 2-25-08

If flowing, method of flow regulation: Valve _____ Other (describe) _____

Static Water Level: 21 feet above below (circle one) land surface Date measured: 2-26-08

Method of Measurement (circle one) steel tape electric tape air line other: _____

Hole depth: 125 Well depth: 125 Well grouted to a depth of 10 feet

Type of grout (circle one): Cement Bentonite Mix

Casing length: 8.5 feet Casing diameter: 16 inches Type of casing: PVC

Screen length: 40 feet Screen diameter: 16 inches Type of screen: PVC

Screen slot size: .050 inches Setting depth: From 86 feet to 125 feet

Type of completion (circle all applicable): Gravel packed Underreamed Telescoped Open hole Natural Development

Other (describe): _____


Top of lap pipe or reduction in casing: _____ feet. If telescoped or more than one screen, describe on back of page

Logs run (circle all applicable): No log run Electric Gamma Ray Density Sonic Neutron Other: _____

Name of organization running log(s): _____

I certify that the well was drilled, constructed, and completed in accordance with all applicable requirements of the Mississippi Department of Environmental Quality and/or the Mississippi Department of Health regulations and state laws.

Irrigation Equipment Inc.
Patrick M. Chism 0695

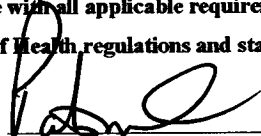

Print Name of Water Well Contractor and License No.

Signature of Water Well Contractor

RECEIVED
 MAR 03 2008
 BY: OLWR

STATE WELL REPORT

Part 2

Pump Installer's Completion Report
 Mississippi Department of Environmental Quality
 Office of Land and Water Resources
 P.O. Box 10631
 Jackson, MS 39289-0631
 (601)961-5210
 (601)354-6938 (fax)

County: Leflore
 Permit #: _____
 Driller: Irrigation Equipment
 Date completed: 2-25-08

For Office Use Only:

Aquifer: _____
 Well #: E-90
 Elevation: _____

This report should be prepared by the pump installer in detail and filed with the Department within 30 days of the installation of pump.

Well Owner Information	Well Location
Owner Name: <u>New Hope Farms</u>	Latitude: _____ Longitude: _____
Mailing Address: <u>C/O Wayne Bush</u> <u>49665 County Rd 559</u> <u>Schlater Ms. 38952</u> <small>City State Zip Code</small>	Method of Lat/Long (circle one): Conventional Survey, USGS quad, Hand-held GPS, Survey-grade GPS <u>SW 1/4 SE 1/4 Sec 29 Twn 21N Rng 1E</u>
Telephone No. <u>662 658-1166</u>	Distance Direction Nearest Town <u>1 Miles W of Money</u>

Pump Type Circle one	Power Type Circle one
Air Lift Jet Submersible	Diesel Engine Gasoline Engine Natural Gas
Bucket Piston <u>Turbine</u>	<u>Electric Motor</u> Hand Tractor PTO
Centrifugal Rotary Flowing Well	Windmill Other (specify): _____
Other (specify): _____	Horse Power Rating of Motor: _____
Date Pump Installed: <u>2-26-08</u>	Setting Depth: <u>70</u> feet
Rated Pump Capacity: <u>2800[±]</u> Gallons Per Minute	Number of Stages: <u>1</u>



RECEIVED
 MAR 03 2008
 BY: OLWR

Pump Test Data	Method of Measuring Water Level Circle one
Date Well Tested: _____	Air Line Electric Measuring Line Steel Tape
Static Water Level (A): _____ Feet Below Land Surface	Other (specify): _____
Pumping Water Level (B): _____ Feet Below Land Surface	For flowing well, measured shut in head: _____ feet
Drawdown [(B) - (A)]: _____ Feet Below Land Surface	Well yielded _____ GPM with a drawdown of _____ feet after _____ hours of pumping
Test Pumping Rate: _____ Gallons Per Minute	
Duration of Pump Test (minimum 4 hours): _____ hours	

I HEREBY CERTIFY that the above statements are true to the best of my knowledge

Patrick M. Chism 0695
 Print Name of Pump Installer and License No. (if applicable) Signature of Pump Installer


New Hope Farms Map

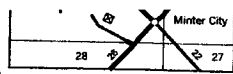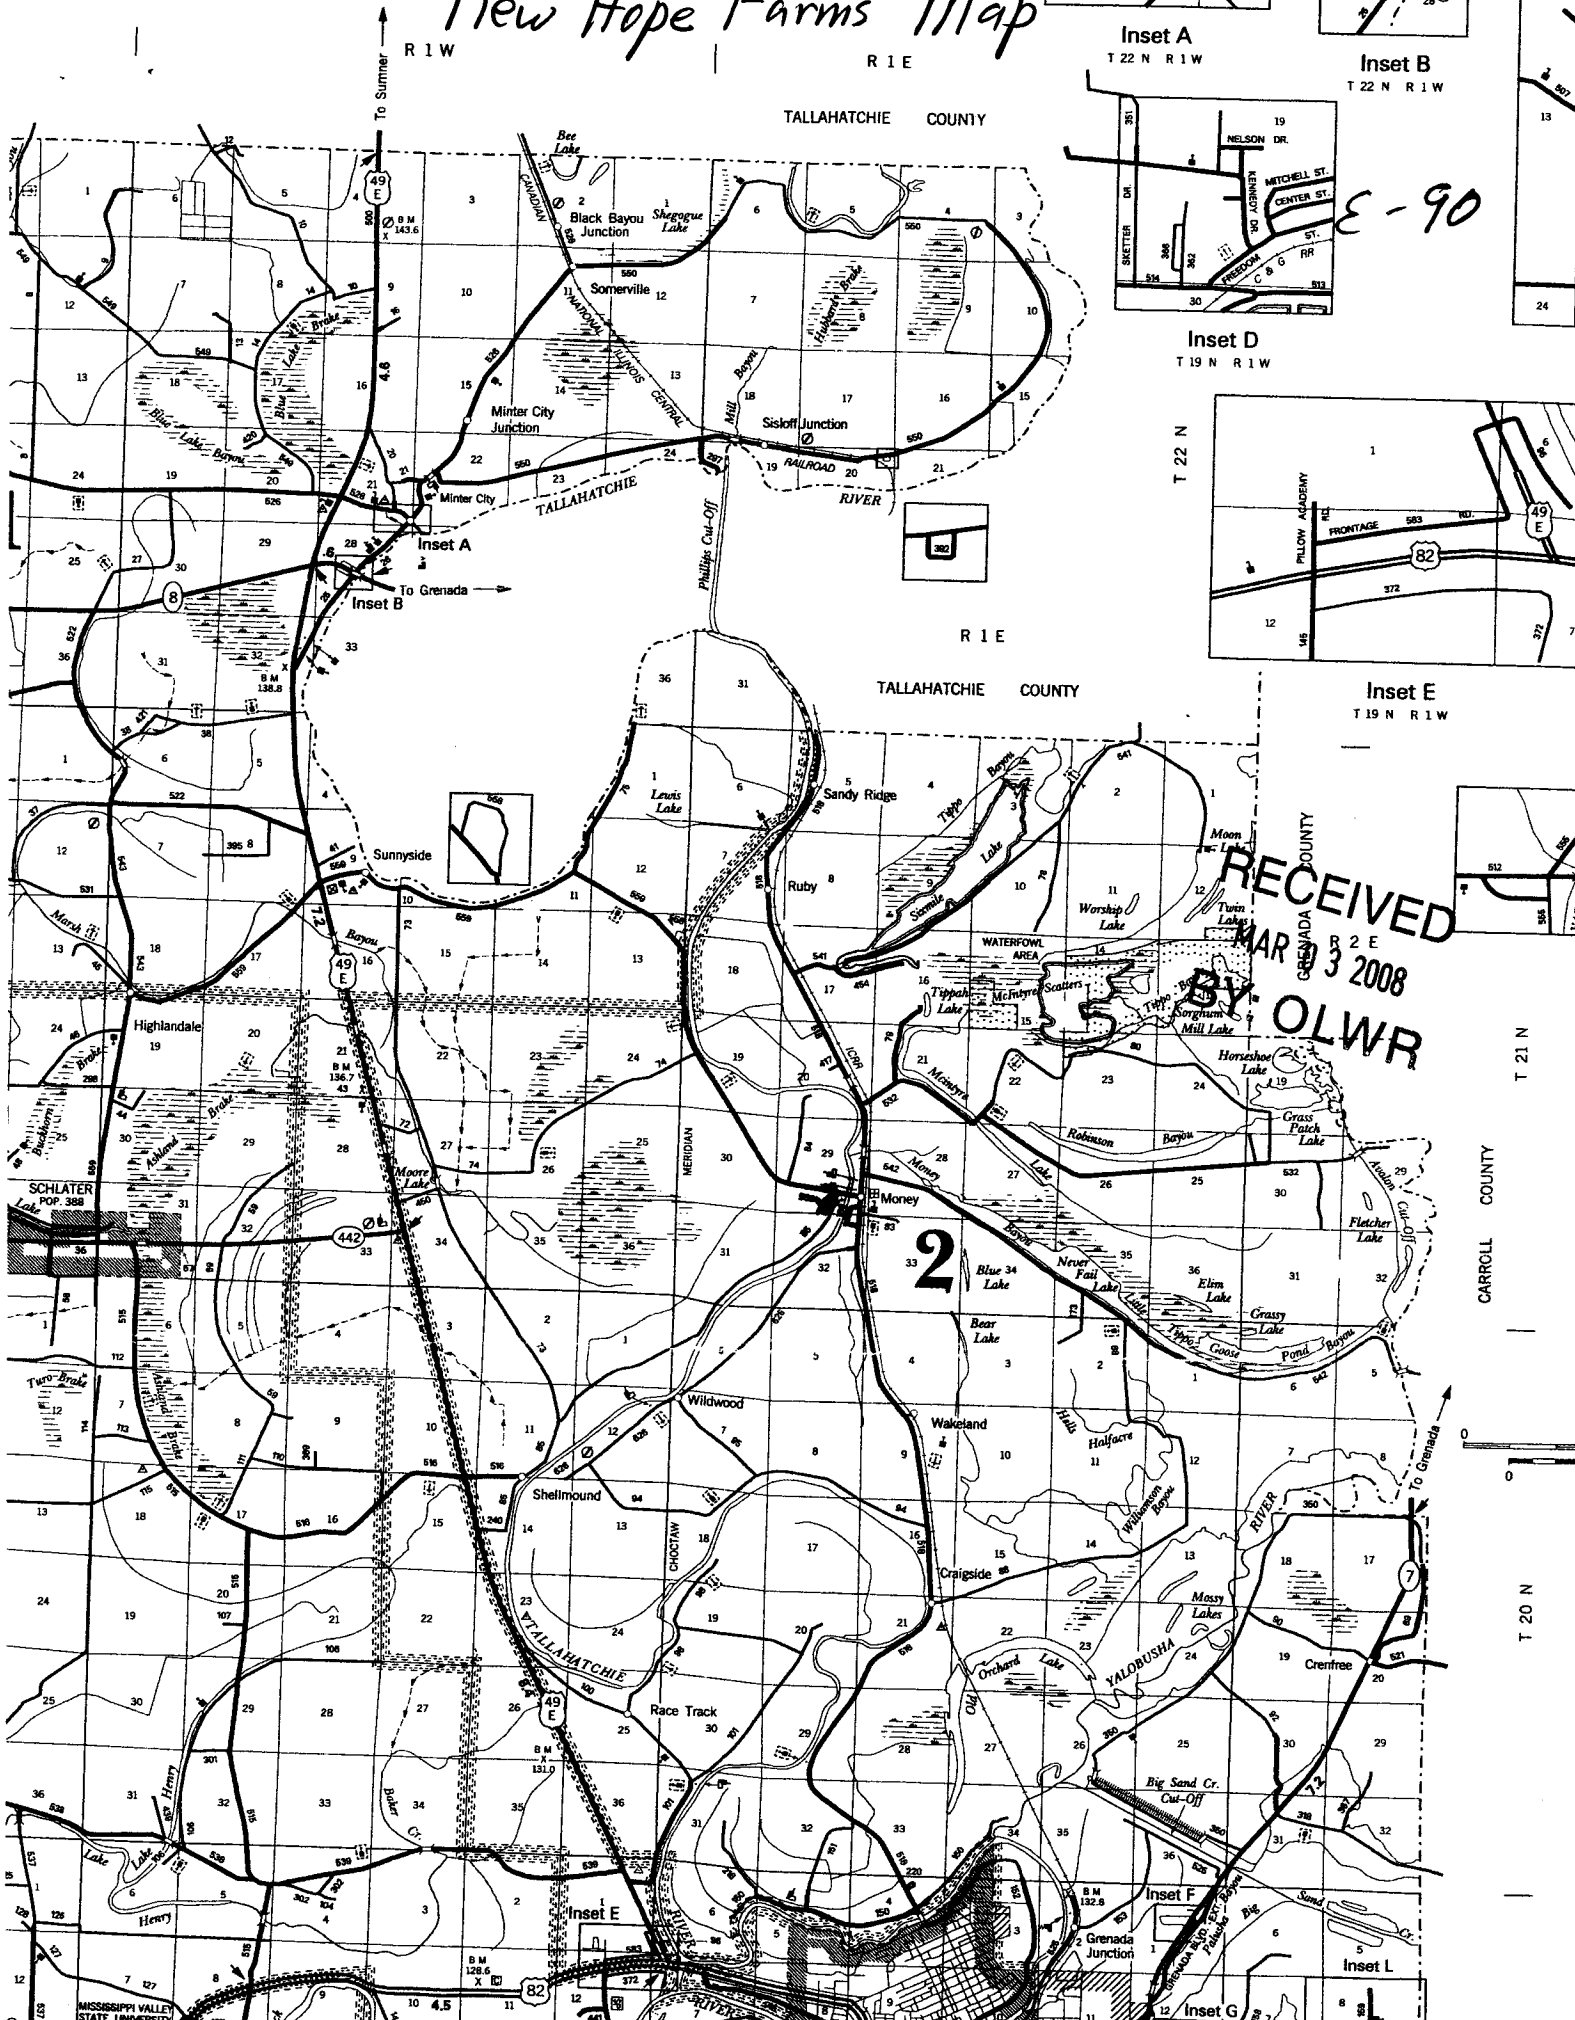

Inset A
T 22 N R 1 W




Inset B
T 22 N R 1 W

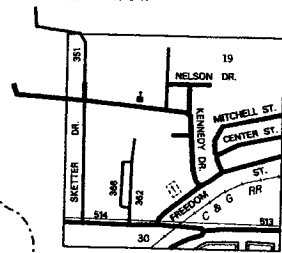

E-90

Inset D
T 19 N R 1 W

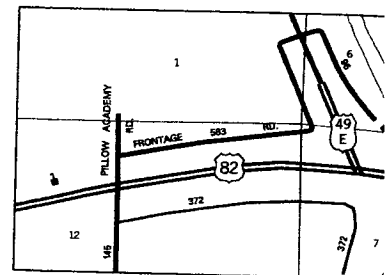

Inset E
T 19 N R 1 W

RECEIVED
MAR 23 2008
BY
OLWR