

Leflore
E 2000
5/14/76

MISSISSIPPI
BOARD OF WATER COMMISSIONERS
416 North State Street
Jackson, Mississippi 39201

WATER WELL DRILLERS LOG


May 14 19 76 Bruce Berryman Leflore
date well completed firm name county well located
Greenwood, Miss.

LANDOWNER:	description of formations encountered	from	to
Roy Petty	Clay	0	10
Rt. 3. Box 350	Sand	10	80
Greenwood, Miss.	Sand & Gravel	80	100
(mailing address)	White sand & clay	100	120
WELL LOCATION:	Clay	120	180
sec. 26 T. 11 N R. 1 E	White sand & clay	180	200
3 miles NE of MONEY.	Hard clay & str. rock	200	220
(distance) (direction) (nearest town)	Green sand	220	240
WELL PURPOSE: Home	Clay & Rock	240	250
(home, irrigation, municipal, industrial)	Green sand	250	260
WELL COMPLETION DATA:	Shale	260	300
(1) diameter (inches) 4" x 2"	Sandy shale	300	370
(2) total depth (feet) 672'	Clay	370	400
(3) static water level (feet) flow below top of ground	Shale	400	440
Black - 105'	Shale str. sand	440	480
(4) casing 2" Galv. - 546'	Hard shale	480	530
(material) (depth)	Hard sand	530	550
(size) If telescope see back.	Shale	550	560
(5) screen 20' 652'	Brown sand	560	590
(length) (depth to top)	Shale	590	620
.010 stainless steel	Clay	620	630
(size) (material)	Sand	630	680
(6) pump 1 hp. 12			
(HP) (yield gpm)			
Electric			
(type power)			
(7) electric log No			
(yes or no)			
(organization running log)			
(8) how well bottom plugged B.P.V.			
DRILLERS REMARKS:			

DEPARTMENT OF WATER CONTROL
MAY 18 1976

If well telescopes please sketch and show depths.

GROUND LEVEL

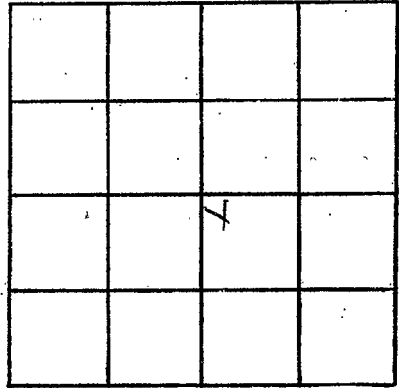

SECTION 26

Please indicate well location X.

ADDITIONAL INFORMATION

If more than one screen, show locations of each on sketch.