

MISSISSIPPI DEPARTMENT OF ENVIRONMENTAL QUALITY

Office of Land and Water Resources

P. O. Box 10631
Jackson, MS 39289-0631
WATER WELL DRILLERS LOG

COUNTY WELL LOCATED LeFlore	
WELL NUMBER E 2009	CODED
DATE WELL COMPLETED 9-20-99	

PERMIT NUMBER
NAME OF DRILLING FIRM IRRIGATION EQUIPMENT
601/837-2555

NAME & MAILING ADDRESS OF LANDOWNER BACKWATER BRAKE Timber Co.			
Box 551			
Greenwood, MS 38930			
WELL LOCATION	SEC	TOWNSHIP	RANGE
NE/SW	22	21	1
DISTANCE		DIRECTION	NEAREST TOWN
3 Miles		NE	Money
OTHER LANDMARK			
WELL PURPOSE: Home, Irrigation, Municipal, Industrial, Fish Pond, etc.			

PUMP DATA			
PUMP TYPE (Circle One): <input checked="" type="radio"/> Submersible Turbine Jet Flowing Well, Other (Describe) _____			
POWER TYPE (Circle One): <input checked="" type="radio"/> Electric Tractor Diesel Gasoline Butane, Other (Describe) _____ H/P 15			
Pump Capacity (GPM)	No. of Stages	Setting Depth	
750	1	80 FT.	
PUMP TEST			
Well yielded _____ GPM with a drawdown of _____ ft. after _____ hours of pumping			

WELL DATA		
Well Depth 116	Casing Diameter (In.) 10	Casing Length (Ft.) 76
Type of Casing PVC	Hole Depth 116	Depth to Static Water Level 16 ft.
TYPE OF COMPLETION: (Circle One or More): <input checked="" type="radio"/> Gravel Packed <input type="radio"/> Underreamed <input type="radio"/> Telescoped, <input type="radio"/> Natural Development <input type="radio"/> Open Hole <input type="radio"/> Other (Describe) _____		

LOG DATA	
TYPE OF LOG RUN (Circle One): <input type="radio"/> No Log Run, <input type="radio"/> Electric, <input type="radio"/> Gamma Ray, <input type="radio"/> Density, <input type="radio"/> Sonic, <input type="radio"/> Neutron, Other (Describe) _____	
Name of Organization Running Log	


WELL GROUTED TO A DEPTH OF _____ FEET
Type Grout (circle one): Cement, Bentonite, or Mix

GEOLOGIC DATA (Office Use Only)			
Surface Elev.	Geologic Unit	Unit Thickness	Depth to Top
Subs. SWL	Date	Analysis	Aquifer Test

SCREEN DATA		
Diameter - Inches 10	Length - Feet 40	Slot Size - Inches .050
Screen Type PVC		Depth to Bottom - Feet 116

Driller's Remarks	

DESCRIPTION OF FORMATIONS ENCOUNTERED	FROM	TO
clay	0	18
FINE SAND	18	35
FINE SAND + Gravel	35	45
med. SAND + Gravel	45	116

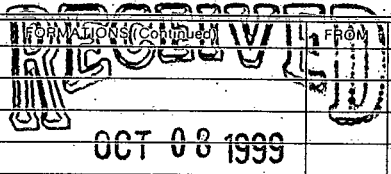

Dept. of Environmental Quality
Office of Land & Water Resources

IF MORE SPACE IS NEEDED, USE BACK

If well telescopes please sketch and show depths.

GROUND LEVEL

	X		

SECTION 22

Please indicate well location X.

ADDITIONAL INFORMATION

If more than one screen,
show location of each on sketch.