

Leflore
F 13
6-15-70

MISSISSIPPI
 BOARD OF WATER COMMISSIONERS
 416 North State Street
 Jackson, Mississippi 39201

CODED


WATER WELL DRILLERS LOG

JUNE 15 19 70 BUTANE GAS CO LEFLORE
 date well completed firm name county well located

LANDOWNER: C. L. PATRIDGE
SCHLATER MISS
 (mailing address)

description of formations encountered	from	to
<u>C. CLAY.</u>	<u>0</u>	<u>34</u>
<u>SAND</u>	<u>34</u>	<u>60</u>
<u>SAND & GRAVEL</u>	<u>60</u>	<u>103</u>

WELL LOCATION:
 sec. 15 T 20 N R 2 E
4 1/2 miles SW of SCHLATER
 (distance) (direction) (nearest town)

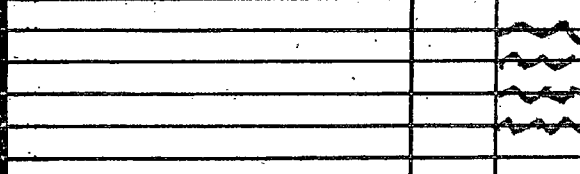

WELL PURPOSE: IRRIGATION
 (home, irrigation, municipal, industrial)

WELL COMPLETION DATA:

(1) diameter (inches) 16

(2) total depth (feet) 103

(3) static water level (feet) 17' below above top of ground.

(4) casing 16 STEEL 63
 (material) (depth)

(size) if telescope see back.

(5) screen 40 63
 (length) (depth to top)

16 BLACK STEEL
 (size) (material)

(6) pump 50 3000
 (HP) (yield gpm)

ELER
 (type power)

(7) electric log NO
 (yes or no)

(organization running log)

(8) how well bottom plugged STEEL PLATE.

CODED

DRILLERS REMARKS: _____

JUN 17 1970

