

Leflore  
F 13  
6-16-70

MISSISSIPPI  
 BOARD OF WATER COMMISSIONERS  
 416 North State Street  
 Jackson, Mississippi 39201

**CODED**

WATER WELL DRILLERS LOG

JUNE 16 19 70 BUTANE GAS CO. LEFLORE  
 date well completed firm name county well located

LANDOWNER: <u>C.L. PATRIDGE</u>	description of formations encountered	from	to
<u>SCHLATER MISS.</u>			
(mailing address)	<u>CLAY</u>	<u>0</u>	<u>34</u>
WELL LOCATION: sec. <u>15</u> T <u>20</u> N R <u>2</u> W <u>4</u> miles <u>SW</u> of <u>SCHLATER</u> (distance) (direction) (nearest town)	<u>SAND</u>	<u>34</u>	<u>60</u>
WELL PURPOSE: <u>IRRIGATION</u> (home, irrigation, municipal, industrial)	<u>SAND &amp; GRAVEL</u>	<u>60</u>	<u>103</u>
WELL COMPLETION DATA: (1) diameter (inches) <u>16'</u> (2) total depth (feet) <u>103</u> (3) static water level (feet) <u>17</u> below top of ground <u>above</u> (4) casing <u>STEEL</u> <u>603</u> (material) (depth) (size) if telescope see back. (5) screen <u>40</u> <u>63</u> (length) (depth to top) <u>16</u> <u>BLACK STEEL</u> (size) (material) (6) pump <u>50</u> <u>3000</u> (HP) (yield gpm) <u>ELBR</u> (type power) (7) electric log <u>NO</u> (yes or no) (organization running log) (8) how well bottom plugged <u>STEEL PLATE</u>			
DRILLERS REMARKS:			


**CODED**

JUL 1 1970

MISC.

If well telescopes please sketch and show depths.

GROUND LEVEL

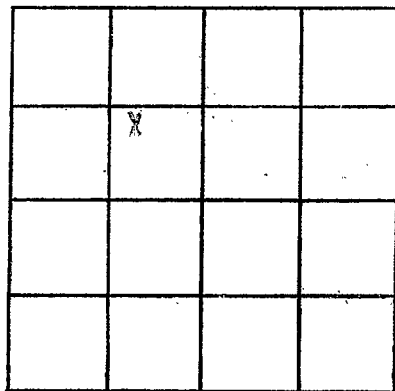

SECTION 5

Please indicate well location X.

ADDITIONAL INFORMATION

If more than one screen, show locations of each on sketch.