

LEFLORE
F-14
7-20-71

MISSISSIPPI
 BOARD OF WATER COMMISSIONERS
 416 North State Street
 Jackson, Mississippi 39201

CODED

WATER WELL DRILLERS LOG
BUTANE GAS CO. OF GREENWOOD

7-20-71 19 POST OFFICE BOX 1139 GREENWOOD, MISS. 39300 Leflore
 date well completed firm name county well located

LANDOWNER:
C. L. PATRIDGE
Schlater
 (mailing address)

description of formations encountered	from	to
CLAY	0	18
SAND & GRAVEL	18	75

WELL LOCATION:
 sec. 4 T. 20 N. R. 2 E. S. 5 W.
3 miles SW of Schlater
 (distance) (direction) (nearest town)

WELL PURPOSE: HO & FARM
 (home, irrigation, municipal, industrial)

- WELL COMPLETION DATA:**
- (1) diameter (inches) 4"
 - (2) total depth (feet) 75
 - (3) static water level (feet) 18 below top of ground.
 - (4) casing PVC (material), 55 (depth)
4" (size) if telescope see back.
 - (5) screen 20' (length), 55 (depth to top)
4" (size), PVC (material)
 - (6) pump 3 (HP), 60 (yield gpm).
ELEC (type power)
 - (7) electric log (yes or no)
 (organization running log)
 - (8) how well bottom plugged LEAD PLUG

CODED


AUG 9 - 1971

MRS. BO. OF WATER COMMISSIONERS

DRILLERS REMARKS:

If well telescopes please sketch and show depths.

GROUND LEVEL

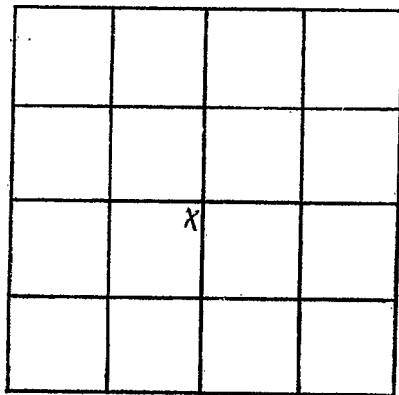

SECTION 4

Please indicate well location X.

ADDITIONAL INFORMATION

If more than one screen, show locations of each on sketch.