

LOFLORE
F-15
8-14-63

LOFLORE
SUNFLOWER

WATER WELL DRILLERS LOG

Date: 8/14, 1963, Driller: Dallas Wells & Supply Co. County: [blank]

CODED

- (1) Owner of Land: H. M. Arant
(Name)
Ruleville, Miss
(Address)
- (2) Location: 1/4, 1/4, Sec. 33 T20R2W
5 miles east of Ruleville
(distance) (direction) (Nearest Town)
- (3) Topography: Flat
(Hilly) (Flat) (Level)
- (4) Purpose of Well: Irrigation
(Domestic Irrigation Municipal, Industrial, Other)

Description & Color of Materials Sand, Clay, Red Clay, Shell, etc.	Thick- ness Feet	Depth Feet
Clay sand	64	
Sand medium	8	72
Blue clay	19	91
Med. Sand & Gravel	25	116

Information upon completion of well:


- (1) Diameter 10 inches.
- (2) Total Depth 116 feet.
- (3) Water Level 18 feet below top of ground.
- (4) Cased to _____, Size _____
- (5) Screen: Size 10, Length 30
- (6) Were any formations sealed against pollution?
_____ yes, no.

CODED

If YES depth of formation _____

Why _____

Drillers Remarks: _____

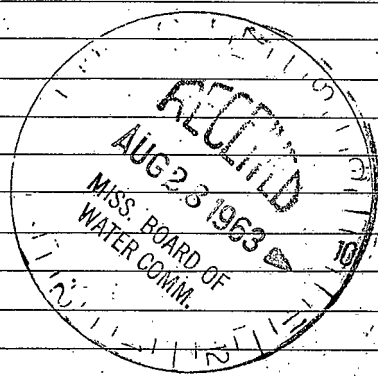

(Use Back Side)

Well No.

100
100
