

**Leflore**  
**F16**  
**2-25-72**

MISSISSIPPI  
 BOARD OF WATER COMMISSIONERS  
 416 North State Street  
 Jackson, Mississippi 39201

**CODED**

**WATER WELL DRILLERS LOG**

2-25 1972 **DYER WELL & IRRIGATION SERVICE** **LEFLORE**  
 date well completed firm name county well located

**LANDOWNER:**  
 WILLIAM TACKETT  
~~GILSON~~

description of formations encountered	from to	
	feet	feet
CLAY	0	25
SAND	25	37
SAND-GRAVEL	37	84
GRAVEL	84	113

**BELZONI MISS**  
 (mailing address)

**WELL LOCATION:**  
 sec. 20 T 20 R 2 E  
 6 1/2 miles N.W. of DENA  
 (distance) (direction) (nearest town)

**WELL PURPOSE:** I.R.E.  
 (home, irrigation, municipal, industrial)

**WELL COMPLETION DATA:**

(1) diameter (inches) 16"

(2) total depth (feet) 113'

(3) static water level (feet) 20 below above top of ground.

(4) casing BUC IR. 73' (material), (depth)  
 16" (size) if telescope see back.

(5) screen 40' 73' (length), (depth to top)  
 16" BUC IR. (size), (material) 2500

(6) pump 50 (HP) (yield gpm)  
 ELEC (type power)

(7) electric log NO (yes or no)

(organization running log)

(8) how well bottom plugged PLATE

**CODED**


JAN 19 1972

**DRILLERS REMARKS:**

MISS. DEP. OF  
 WATER RESOURCES  
 JACKSON, MISSISSIPPI

If well telescopes please sketch and show depths.

GROUND LEVEL

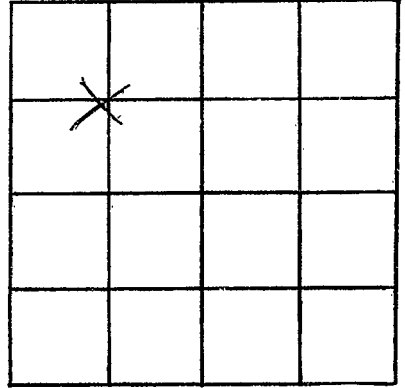

SECTION 20

Please indicate well location X.

ADDITIONAL INFORMATION

If more than one screen,  
show locations of each on sketch.