

LEFLORE
F 19
5-17-74

MISSISSIPPI
BOARD OF WATER COMMISSIONERS
416 North State Street
Jackson, Mississippi 39201

CODED

WATER WELL DRILLERS LOG

BUTANE GAS CO. OF GREENWOOD Leflore

5/17/74 19 date well completed firm name county well located

LANDOWNER:

William Tackett

Ida Bena, Miss
(mailing address)

description of formations encountered

from

to

Clay 0 35
SANDY GRAVEL 35 103

WELL LOCATION:

sec. 20 T. 20 N R. 2 E
S W
4 1/2 miles SW of Schlater
(distance) (direction) (nearest town)

WELL PURPOSE: IRR
(home, irrigation, municipal, industrial)

WELL COMPLETION DATA:

- (1) diameter (inches) 16"
- (2) total depth (feet) 103
- (3) static water level (feet) 10 below above top of ground.
- (4) casing Steel 63 (material) (depth)
16" (size) if telescope see back.
- (5) screen 40' 63 (length) (depth to top)
16" (size) Steel (material)
- (6) pump 60 2500 (HP) (yield gpm)
Elec (type power)
- (7) electric log NO (yes or no)

(organization running log)

(8) how well bottom plugged
Steel Plate


DRILLERS REMARKS:

CODED

MAY 22 1974
MISS. BD. OF WATER COMM.

If well telescopes please sketch and show depths.

GROUND LEVEL

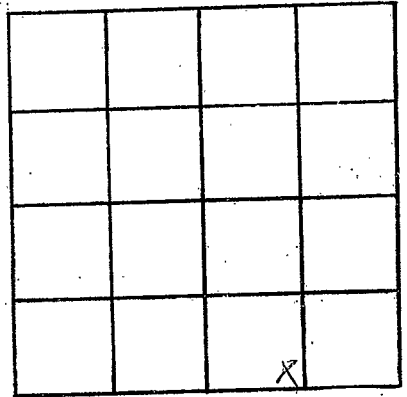

SECTION 20

Please indicate well location X.

ADDITIONAL INFORMATION

If more than one screen,
show locations of each on sketch.