

LEFLORE

F21

7-29-74

MISSISSIPPI BOARD OF WATER COMMISSIONERS 416 North State Street Jackson, Mississippi 39201

CODED

WATER WELL DRILLERS LOG

BUTANE GAS CO. OF GREENWOOD Leflore

7-29-74 19 date well completed

firm name

county well located

LANDOWNER:

E. L. GILLILAND

description of formations encountered

from to

Ida BENA

(mailing address)

Clay	0	30
Sand	30	73
Sand & Gravel	73	147
Clay	147	193
Slate	193	270
Rock	270	271
Clay & Slate	271	408
Sand	408	500
Slate	500	565
Slate & Rock	565	716
Rock	716	717
Slate (SANDY)	717	895
SANDY SLATE	895	1050
Sand	1050	1199
Slate	1199	1208


WELL LOCATION:

sec. 22 T 20 N R 2 E S 6 W 4 miles SW of Schlater (distance) (direction) (nearest town)

WELL PURPOSE: Home (home, irrigation, municipal, industrial)

WELL COMPLETION DATA:

- (1) diameter (inches) 4 1/2
- (2) total depth (feet) 1176
- (3) static water level (feet) 20 below top of ground.
- (4) casing Steel (material), 1156 (depth), 4 1/2 (size) if telescope see back.
- (5) screen 20 (length), 1156 (depth to top), 2" (size), Stainless (material)
- (6) pump 20 (HP), 20 (yield gpm)
- (7) electric log (yes or no)
- (8) how well bottom plugged

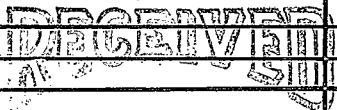

AUG - 8 1974

DRILLERS REMARKS:

