

LEFLORE
F 22
11-14-74

MISSISSIPPI
BOARD OF WATER COMMISSIONERS
416 North State Street
Jackson, Mississippi 39201

CODED

WATER WELL DRILLERS LOG

~~MUTANT GAS CO. OF GREENWOOD~~ Leflore


11-14-74
date well completed

firm name

county well located

LANDOWNER:	description of formations encountered	from	to
Robert Kelle	Clay	0	18
Itta Bena	Sand	18	60
(mailing address)	Sand & Gravel	60	140
WELL LOCATION:	Sand	140	370
sec. <u>26</u> T <u>20</u> N R. <u>2</u> E	Clay	370	400
& S W	Shale	400	450
<u>5</u> miles <u>NW</u> of <u>Itta Bena</u>	Sand	450	490
(distance) (direction) (nearest town)			
WELL PURPOSE: <u>Home</u>			
(home, irrigation, municipal, industrial)			
WELL COMPLETION DATA:			
(1) diameter (inches) <u>4x2</u>			
(2) total depth (feet) <u>490</u>			
(3) static water level (feet) <u>18</u> above below top of ground.			
(4) casing <u>PVC</u> <u>470</u>			
(material) (depth)			
<u>4x2</u> If telescope see back.			
(size)			
(5) screen <u>20'</u> <u>470</u>			
(length) (depth to top)			
<u>2"</u> <u>Stainless</u>			
(size) (material)			
(6) pump <u>3/4</u> <u>20</u>			
(HP) (yield gpm)			
<u>Elec.</u>			
(type power)			
(7) electric log <u>No</u>			
(yes or no)			
(organization running log)			
(8) how well bottom plugged			
<u>Lead plug</u>			
DRILLERS REMARKS:			


CODED

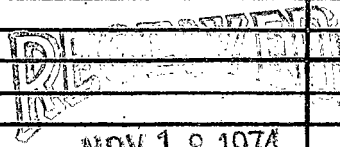

NOV 18 1974

If well telescopes please sketch and show depths.

GROUND LEVEL

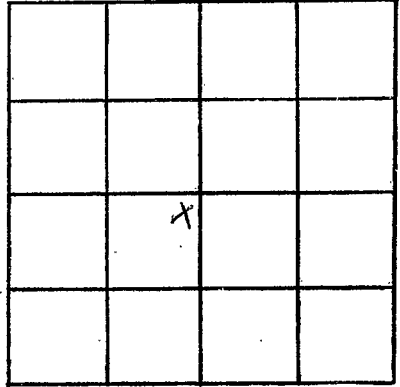

SECTION 26

Please indicate well location X.

ADDITIONAL INFORMATION

If more than one screen, show locations of each on sketch.