

Leflore Co
S-4 F 23
6-14-70

MISSISSIPPI
 BOARD OF WATER COMMISSIONERS
 416 North State Street
 Jackson, Mississippi 39201

WATER WELL DRILLERS LOG

CODED

6/14 1970 BUTANE GAS CO LEFLORE
 date well completed firm name county well located

LANDOWNER: RICKS WOOD
PLANTATION
SCHLATER, Miss
 (mailing address)
 WELL LOCATION:
 sec. 7 T 20 (N) R 2 (W)
2 1/2 miles S of SCHLAYER
 (distance) (direction) (nearest town)

| description of formations encountered | from | to |
|---------------------------------------|------|-----|
| CLAY | 0 | 18 |
| SAND | 18 | 60 |
| SAND & GRAVEL | 60 | 120 |
| SAND & CLAY | 120 | 200 |
| SAND - | 200 | 270 |
| SAND & SHELL | 270 | 380 |
| CLAY | 380 | 490 |
| SHELL | 490 | 760 |
| SHELL & CLAY | 760 | 850 |
| SAND & SHELL | 850 | 900 |
| BROWN SAND | 900 | 930 |
| WHITE SAND. | 930 | 975 |

WELL PURPOSE: HOME
 (home, irrigation, municipal, industrial)

WELL COMPLETION DATA:
 (1) diameter (inches) 4 3/4 x 3
 (2) total depth (feet) 975
 (3) static water level (feet) 20 below above top of ground.
 (4) casing 4" STEEL 105 (material) (depth)
3" STEEL 840 If telescope see back.
 (size)
 (5) screen 30" 3/4 975 (length) (depth to top)
3" STAINLESS STEEL (size) (material)
 (6) pump 3 HP SUB 48 GAL (HP) (yield gpm)
ELC (type power)
 (7) electric log NO (yes or no)
 (organization running log)

CODED

(8) how well bottom plugged BACK WASH VALVE

DRILLERS REMARKS:

JUL 1 1970

MISS. BD. OF
 WATER COM.


If well telescopes please sketch and show depths.

GROUND LEVEL

105

840

30

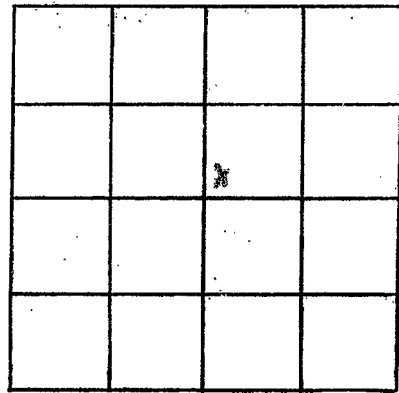

SECTION _____

Please indicate well location X.

ADDITIONAL INFORMATION

A series of horizontal lines for recording additional information, starting below the 'ADDITIONAL INFORMATION' header.

If more than one screen, show locations of each on sketch.