

LEFLORE
F 27
2-1-75

MISSISSIPPI
 BOARD OF WATER COMMISSIONERS
 416 North State Street
 Jackson, Mississippi 39201

COE

WATER WELL DRILLERS LOG

3/1/75 19 ENTANE GAS CO. OF GREENWOOD Leflore
 date well completed firm name county well located

LANDOWNER:
D. H. STRAIN
Itta Bena
 (mailing address)

description of formations encountered	from	to
Clay	0	20
Sand	20	40
Sand + Gravel	40	50
Gravel	50	60
Fine Sand	60	70
Sand + Gravel	70	95

WELL LOCATION:
 sec. 55 T. 20 N. R. 2 E. S. 8 W.
4 miles NW of Itta Bena
 (distance) (direction) (nearest town)

WELL PURPOSE: FR
 (home, irrigation, municipal, industrial)

WELL COMPLETION DATA:

(1) diameter (inches) 16"

(2) total depth (feet) 95

(3) static water level (feet) 17 above top of ground.

(4) casing Steel, 55,
 (material) (depth)
16" if telescope see back.
 (size)

(5) screen 40', 55
 (length) (depth to top)
16", Steel
 (size) (material)


(6) pump 60 3000
 (HP) (yield gpm)
Diesel
 (type power)

(7) electric log No
 (yes or no)

(organization running log)

(8) how well bottom plugged
Steel Plate


DRILLERS REMARKS:

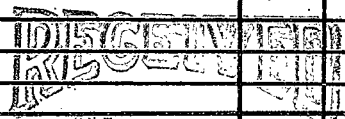

MAR 21 1975

If well telescopes please sketch and show depths.

GROUND LEVEL

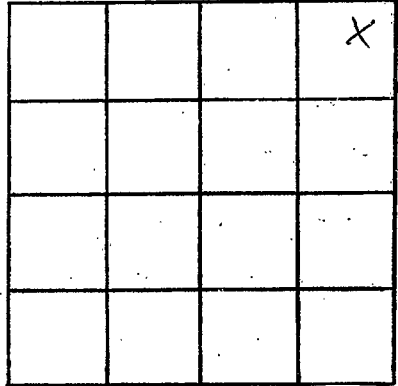

SECTION 35

Please indicate well location X.

ADDITIONAL INFORMATION

If more than one screen, show locations of each on sketch.