

LEFLORE  
F28  
3-6-75

MISSISSIPPI  
BOARD OF WATER COMMISSIONERS  
416 North State Street  
Jackson, Mississippi 39201

CODED

WATER WELL DRILLERS LOG

2-6-75 1975 date well completed  
ENTANE GAS CO. OF GREENWOOD firm name  
Leflore county well located

| LANDOWNER:  | description of formations encountered | from | to |
|---|---------------------------------------|------|----|
| Robert Kalle  |                                       |      |    |
| Itha BENA<br>(mailing address)                                  | Clay                                  | 0    | 30 |
|   | SAND + Pea GRAVEL                     | 30   | 40 |
|   | SAND + GRAVEL                         | 40   | 90 |
| WELL LOCATION:  |                                       |      |    |
| sec. 10 T. 20 N R. 2 E<br>S W                                   |                                       |      |    |
| 2 miles SW of Schlater<br>(distance) (direction) (nearest town) |                                       |      |    |
| WELL PURPOSE: Ink<br>(home, irrigation, municipal, industrial)  |                                       |      |    |
| WELL COMPLETION DATA:   |                                       |      |    |
| (1) diameter (inches) 16"                                       |                                       |      |    |
| (2) total depth (feet) 90                                       |                                       |      |    |
| (3) static water level (feet) 16 above<br>top of ground.        |                                       |      |    |
| (4) casing Steel 50<br>(material) (depth)                       |                                       |      |    |
| 16' If telescope see back.<br>(size)                            |                                       |      |    |
| (5) screen 40' 50<br>(length) (depth to top)                    |                                       |      |    |
| 16" Steel<br>(size) (material)                                  |                                       |      |    |
| (6) pump 60 3000<br>(HP) (yield gpm)                            |                                       |      |    |
| Diesel<br>(type power)  |                                       |      |    |
| (7) electric log NO<br>(yes or no)                              |                                       |      |    |
| (organization running log)                                      |                                       |      |    |
| (8) how well bottom plugged<br>Steel Plates                     |                                       |      |    |
| DRILLERS REMARKS:   |                                       |      |    |

CODED


RECORDED  
INDEXED

MAR 24 1975

MISS. Bd. OF WATER COMM

If well telescopes please sketch and show depths.

GROUND LEVEL

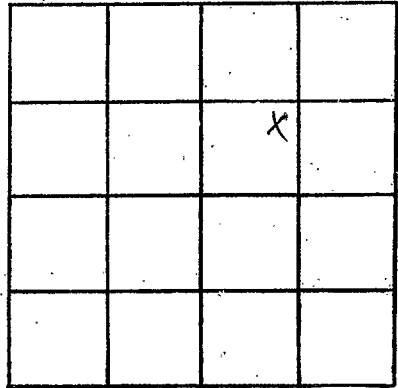

SECTION 10

Please indicate well location X.

ADDITIONAL INFORMATION

If more than one screen, show locations of each on sketch.