

LEFLORE
F 29
4-15-75

MISSISSIPPI
 BOARD OF WATER COMMISSIONERS
 416 North State Street
 Jackson, Mississippi 39201

WATER WELL DRILLERS LOG **CODED**

4-15-75 BUTANE GAS CO. OF GREENWOOD Leflore
 date well completed 19 firm name county well located

LANDOWNER:
D. W. STRAIN
ITTA BENA
 (mailing address)

WELL LOCATION:
 sec 26 T 20 N R 2 E
6 miles NW of ITTA BENA
 (distance) (direction) (nearest town)

description of formations encountered	from	to
<u>Clay</u>	<u>0</u>	<u>10</u>
<u>SAND + Pea GRAVEL</u>	<u>10</u>	<u>30</u>
<u>SAND</u>	<u>30</u>	<u>50</u>
<u>SAND + Pea GRAVEL</u>	<u>50</u>	<u>60</u>
<u>SAND + GRAVEL</u>	<u>60</u>	<u>100</u>

WELL PURPOSE: IRR
 (home, irrigation, municipal, industrial)

WELL COMPLETION DATA:

(1) diameter (inches) 16"

(2) total depth (feet) 100

(3) static water level (feet) 16 below above top of ground.

(4) casing Steel, 60
 (material) (depth)
16" if telescope see back.
 (size)

(5) screen 40 60
 (length) (depth to top)
16" Steel
 (size) (material)

(6) pump 60 Diesel
 (HP) (yield gpm)
Diesel
 (type power) 2500

(7) electric log NO
 (yes or no)

(organization running log)

(8) how well bottom plugged Steel Plate


CODED

INDEXED
APR 18 1975
MISS. Bd. OF WATER COMM.

DRILLERS REMARKS:

If well telescopes please sketch and show depths.

GROUND LEVEL

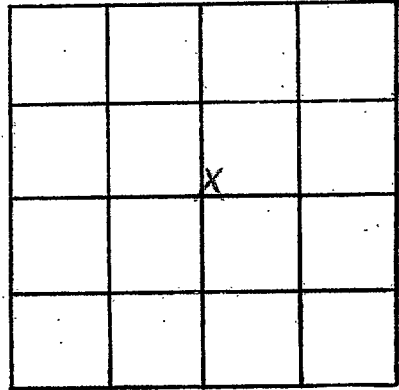

SECTION 26

Please indicate well location X.

ADDITIONAL INFORMATION

If more than one screen, show locations of each on sketch.