

MISSISSIPPI
 BOARD OF WATER COMMISSIONERS
 416 North State Street
 Jackson, Mississippi 39201 **CODED**

WATER WELL DRILLERS LOG

Leflore
F30
3-67

3/24/67 19 BUTANE GAS of GREENWOOD LEFLORE
 date well completed firm name county well located

LANDOWNER:
D. H. STRAIN
ITTA BENA
 (mailing address)

WELL LOCATION:
 sec. 27 T. 20 N R. 2 E
 S W
6 miles N.W. of ITTA BENA
 (distance) (direction) (nearest town)

description of formations encountered	from	to
Top Soil	0	17
FINE SAND	17	35
COARSE SAND & Gravel	35	95

WELL PURPOSE: IRRIGATION
 (home, irrigation, municipal, industrial)

CODED

WELL COMPLETION DATA:

(1) diameter (inches) 16"

(2) total depth (feet) 95'

(3) static water level (feet) 18' below top of ground.

(4) casing ~~16"~~ 55'
 (material) (depth)

16" if telescope see back.
 (size)

(5) screen 40' 55'
 (length) (depth to top)

16" Black
 (size) (material)


(6) pump 50 2500
 (HP) (yield gpm)

LPG
 (type power)

(7) electric log No
 (yes or no)

(organization running log)

(8) how well bottom plugged
STEEL PLATE

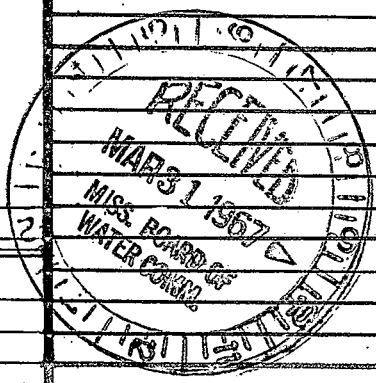

DRILLERS REMARKS:

If well telescopes please sketch and show depths.

GROUND LEVEL

			X

SECTION 27

Please indicate well location X.

ADDITIONAL INFORMATION

If more than one screen,
show locations of each on sketch.