

Leflore
 F33
 6-19-75

MISSISSIPPI
 BOARD OF WATER COMMISSIONERS
 416 North State Street
 Jackson, Mississippi 39201

CODED

WATER WELL DRILLERS LOG

6/19 1975 FIVE COUNTY FARMERS ASSN. LEFLORE
 date well completed firm name county well located

LANDOWNER: J.P. FISHER, JR.

description of formations encountered	from	to
SAND TOPSOIL	0	14
CLAY	14	27
SAND	27	46 1/2
SAND & PEA GRAVEL	46 1/2	118'


CYPRESS LAKE PLANTATION

SUNFLOWER, MISSISSIPPI
 (mailing address)

WELL LOCATION:
 sec. 7 T 20^N R 2^E 15^H
 3 miles EAST of BLAINE
 (distance) (direction) (nearest town)

WELL PURPOSE:
 (home, irrigation, municipal, industrial)

- WELL COMPLETION DATA:
- diameter (inches) 6"
 - total depth (feet) 118'
 - static water level (feet) 14' below top of ground.
 - casing BLACK PIPE 70' (material) (depth)
 6" (size) if telescope see back.
 - screen 48' 70' (length) (depth to top)
 6" BLACK LOUVRE DOERR (size) (material)
 - pump 40 1250 (HP) (yield gpm)
 TRACTOR - PTO (type power)
 - electric log No (yes or no)
 - (organization running log)
 - how well bottom plugged WELDED

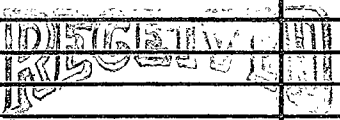


JUNE 22 1975

DRILLERS REMARKS:

MISS. BD. OF WATER COMM

If well telescopes please sketch and show depths.

GROUND LEVEL

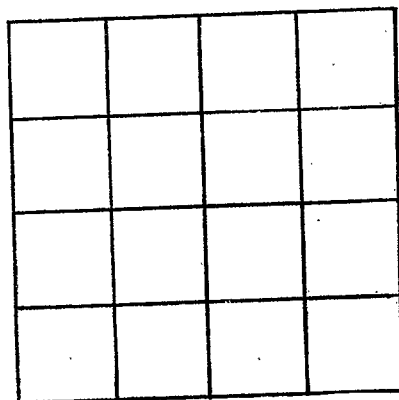

SECTION _____

Please indicate well location X.

ADDITIONAL INFORMATION

If more than one screen, show locations of each on sketch.