

Leflore
EV34
7-11-75

MISSISSIPPI
 BOARD OF WATER COMMISSIONERS
 416 North State Street
 Jackson, Mississippi 39201

WATER WELL DRILLERS LOG

BUTANE GAS CO. OF GREENWOOD *Leflore*


7-11-75 19 date well completed firm name county well located

LANDOWNER:	description of formations encountered	from	to
<i>D. H. Goss</i>			
<i>Greenwood</i> (mailing address)	<i>SAND + GRAVEL</i>	<i>40</i>	<i>130</i>
WELL LOCATION:	<i>Clay</i>	<i>130</i>	<i>180</i>
sec. <i>31</i> T. <i>20</i> N. R. <i>2</i> E. <i>15</i> th	<i>SAND</i>	<i>180</i>	<i>260</i>
<i>3</i> miles <i>NE</i> of <i>Wood</i>	<i>SAND + SLATE</i>	<i>260</i>	<i>444</i>
(distance) (direction) (nearest town)	<i>SLATE</i>	<i>444</i>	<i>575</i>
WELL PURPOSE: <i>farm</i>	<i>SAND</i>	<i>575</i>	<i>637</i>
(home, irrigation, municipal, industrial)			
WELL COMPLETION DATA:			
(1) diameter (inches) <i>2</i>			
(2) total depth (feet) <i>637</i>			
(3) static water level (feet) <i>15</i> below top of ground.			
(4) casing <i>Steel</i> <i>617</i> (material) (depth)			
<i>2"</i> If telescope see back. (size)			
(5) screen <i>20</i> <i>617</i> (length) (depth to top)			
<i>2"</i> <i>Stainless</i> (size) (material)			
(6) pump <i>1/2</i> <i>70</i> (HP) (yield gpm)			
<i>Elec.</i> (type power)			
(7) electric log <i>NO</i> (yes or no)			
(organization running log)			
(8) how well bottom plugged <i>Lead plug</i>			
DRILLERS REMARKS:			

RECEIVED
 JUL 18 1975
 MISS. BU. OF WATER COMMISSIONERS

If well telescopes please sketch and show depths.

GROUND LEVEL

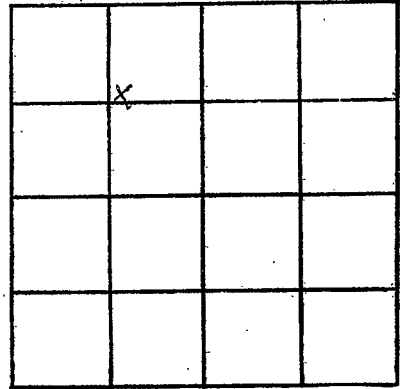

SECTION _____

Please indicate well location X.

ADDITIONAL INFORMATION

If more than one screen, show locations of each on sketch.