

Leflore
 F035
 9-11-75

MISSISSIPPI
 BOARD OF WATER COMMISSIONERS
 416 North State Street
 Jackson, Mississippi 39201

WATER WELL DRILLERS LOG

9-11-75 BUTANE GAS CO. OF GREENWOOD Leflore
 date well completed firm name county well located

LANDOWNER:	description of formations encountered	from	to
William Tackett Schlater (mailing address)			
WELL LOCATION:	CLAY	0	40
sec. <u>20</u> T. <u>20</u> N. R. <u>2</u> E. ^{15th}	SAND	40	70
<u>8</u> miles <u>SW</u> of <u>Schlater</u>	SAND + GRAVEL	70	180
(distance) (direction) (nearest town)	CLAY	180	340
WELL PURPOSE: <u>Home</u>	SAND	340	560
(home, irrigation, municipal, industrial)	CLAY	560	640
WELL COMPLETION DATA:	SILT	640	820
(1) diameter (inches) <u>4 X 2</u>	SAND + SILT	820	1080
(2) total depth (feet) <u>1227</u>	CLAY	1080	1170
(3) static water level (feet) <u>15</u> below above top of ground.	SAND	1170	1233
(4) casing <u>Steel</u> , <u>1207</u> , (material) (depth) <u>4 X 2</u> if telescope see back. (size)			
(5) screen <u>20</u> , <u>1207</u> (length) (depth to top) <u>2"</u> <u>Stainless</u> (size) (material)			
(6) pump <u>1/3</u> , <u>10</u> (HP) (yield gpm) <u>Elec.</u> (type power)			
(7) electric log <u>No</u> (yes or no)			
(organization running log)			
(8) how well bottom plugged <u>BACK PRESSURE VALVE</u>			
DRILLERS REMARKS:			

REGISTERED
 SEP 15 1975

MISS. Bd. OF WATER COMMISSIONERS


If well telescopes please sketch and show depths.

GROUND LEVEL

105' - 4" CASING →

1102' - 2" CASING →

26' - 2" SCREEN →

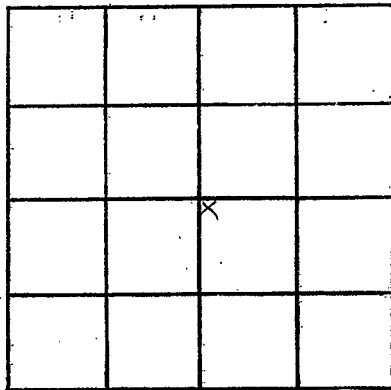

SECTION 20

Please indicate well location X.

ADDITIONAL INFORMATION

If more than one screen, show locations of each on sketch.