

**LEFLORE**  
**F 37**  
**6-18-77**

MISSISSIPPI  
 BOARD OF WATER COMMISSIONERS  
 416 North State Street  
 Jackson, Mississippi 39201

**CODED**

**WATER WELL DRILLERS LOG**

6-18-77 19 BUTANE GAS CO. OF GREENWOOD Leflore  
 date well completed firm name county well located

LANDOWNER: Miller Burt  
Topelo Plantation  
Schlater  
 (mailing address)

WELL LOCATION:  
 sec. 12 T. 20 N. R. 2 W.  
2 1/2 miles SW of Schlater  
 (distance) (direction) (nearest town)

WELL PURPOSE: FAR  
 (home, irrigation, municipal, industrial)

- WELL COMPLETION DATA:
- (1) diameter (inches) 16
  - (2) total depth (feet) 95
  - (3) static water level (feet) \_\_\_\_\_ below above top of ground.
  - (4) casing Steel 55  
 (material) (depth)  
16 If telescope see back.  
 (size)
  - (5) screen 40 55  
 (length) (depth to top)  
16 Steel  
 (size) (material)
  - (6) pump 50 2500  
 (HP) (yield gpm)  
Diesel  
 (type power)
  - (7) electric log NO  
 (yes or no)  
 (organization running log)
  - (8) how well bottom plugged Steel Plate

description of formations encountered	from	to
CLAY	0	10
CLAY + SAND	10	20
SAND	20	30
SAND + Pea Gravel	30	40
SAND + GRAVEL	40	95

**CODED**


**RECEIVED**  
**JUL 18 1977**

MISS. BD. OF WATER COMMISSIONERS

DRILLERS REMARKS:

If well telescopes please sketch and show depths.

GROUND LEVEL

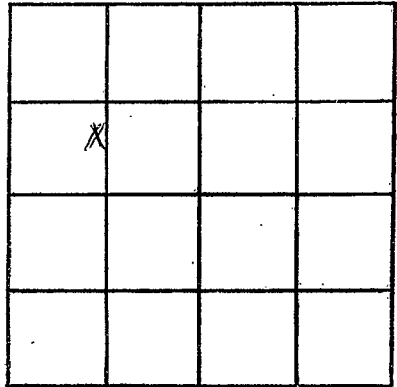

SECTION 12

Please indicate well location X.

ADDITIONAL INFORMATION

If more than one screen, show locations of each on sketch.