

LeFlore  
F 39  
3/4/78

MISSISSIPPI  
BOARD OF WATER COMMISSIONERS CODED  
416 North State Street  
Jackson, Mississippi 39201

WATER WELL DRILLERS LOG  
BUTANE GAS COMPANY

LeFlore

3/4/78  
date well completed 19

OF GREENWOOD  
full name

county well located

LANDOWNER:  
Joe Coleman  
Itha Beda  
(mailing address)

description of formations encountered	from	to
	CLAY	0
FINE SAND	20	30
COARSE SAND	30	40
SAND + GRAVEL	40	100

WELL LOCATION:  
sec. 14 T 20 N R 2 E  
S W  
3 miles SW of Schlater  
(distance) (direction) (nearest town)

WELL PURPOSE: I.R.R.  
(home, irrigation, municipal, industrial)

WELL COMPLETION DATA:  
(1) diameter (inches) 16"  
(2) total depth (feet) 100  
(3) static water level (feet) 18 below top of ground.  
(4) casing Steel, 60 (material) (depth)  
16" if telescope see back. (size)  
(5) screen 40, 60 (length) (depth to top)  
16, Steel (size) (material)  
(6) pump 60, 2500 (HP) (yield gpm)  
Diesel (type power)  
(7) electric log NO (yes or no)  
(organization running log)


(8) how well bottom plugged  
Steel Plate

DRILLERS REMARKS:

RECEIVED  
MAR 24 1978

If well telescopes please sketch and show depths.

GROUND LEVEL

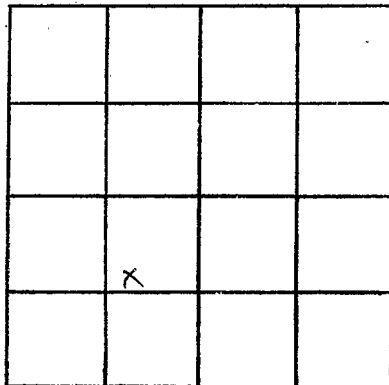

SECTION 14

Please indicate well location X.

ADDITIONAL INFORMATION

If more than one screen,  
show locations of each on sketch.