

LeFlora  
F40  
3/15/78

MISSISSIPPI  
BOARD OF WATER COMMISSIONERS  
416 North State Street  
Jackson, Mississippi 39201

CODED

WATER WELL DRILLERS LOG  
BUTANE GAS COMPANY

LeFlora

3-15-78  
date well completed


OF GREENWOOD  
firm name

county well located

LANDOWNER:	description of formations encountered	from	to
E.L. Gilliland Schlater (mailing address)	Clay Sand Sand + Gravel	0 20 30	20 30 100
WELL LOCATION: sec. 20 T 20 N R 2 E S W 6 miles SW of Schlater (distance) (direction) (nearest town)			
WELL PURPOSE: IRR (home, irrigation, municipal, industrial)			
WELL COMPLETION DATA: (1) diameter (inches) 16" (2) total depth (feet) 100 (3) static water level (feet) 20 below top of ground. (4) casing Steel, 60, (depth) 16" if telescope see back. (size) (5) screen 40, 60 (length) (depth to top) 16", Steel (size) (material) (6) pump 60, 2500 (HP) (yield gpm) Elec. (type power) (7) electric log NO (yes or no) (organization running log)			
DRILLERS REMARKS: Steel PLATE	RECEIVED MAR 21 1978 MISS. BD. OF WATER COMM.		

If well telescopes please sketch and show depths.

GROUND LEVEL

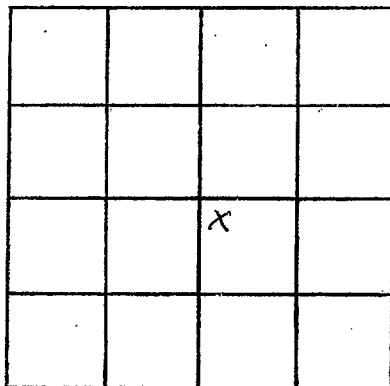

SECTION 20

Please indicate well location X.

ADDITIONAL INFORMATION

If more than one screen,  
show locations of each on sketch.