

LeFlore
 F42
 5/30/78
 1/1

MISSISSIPPI
 BOARD OF WATER COMMISSIONERS
 416 North State Street
 Jackson, Mississippi 39201

WATER WELL DRILLERS LOG
 BUTANE GAS COMPANY

CODED

LeFlore

5/30/78 19
 date well completed

OF GREENWOOD

county well located

LANDOWNER:	description of formations encountered	from	to
William Tackett			
Schluter	Sand + Pea Gravel	53	70
(mailing address)	Sand + Gravel	70	98
WELL LOCATION:			
sec. <u>7</u> T. <u>20</u> N R. <u>2</u> E			
S W			
<u>5 1/2</u> miles <u>SW</u> of <u>Schluter</u>			
(distance) (direction) (nearest town)			
WELL PURPOSE: <u>IRR</u>			
(home, irrigation, municipal, industrial)			
WELL COMPLETION DATA:			
(1) diameter (inches) <u>16"</u>			
(2) total depth (feet) <u>98</u>			
(3) static water level (feet) <u>18</u> below above top of ground.			
(4) casing <u>Steel</u> <u>58</u>			
(material) (depth)			
<u>16"</u> If telescope see back.			
(size)			
(5) screen <u>40</u> <u>58</u>			
(length) (depth to top)			
<u>16"</u> <u>Steel</u>			
(size) (material)			
(6) pump <u>40</u> <u>7000</u>			
(HP) (yield gpm)			
<u>Diesel</u>			
(type power)			
(7) electric log <u>NO</u>			
(yes or no)			
(organization running log)			
(8) how well bottom plugged			
<u>Steel + R</u>			
DRILLERS REMARKS:			


CODED

ACCEPTED
 JUN 23 1978

MISS. BD. OF WATER COMMISSIONERS

If well telescopes please sketch and show depths.

GROUND LEVEL

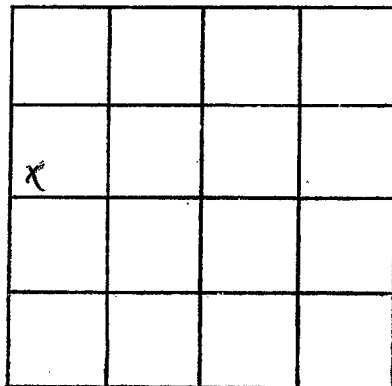

SECTION 7

Please indicate well location X.

ADDITIONAL INFORMATION

If more than one screen, show locations of each on sketch.