

LEFLORE  
 F 45  
 7-31-78

MISSISSIPPI  
 BOARD OF WATER COMMISSIONERS  
 416 North State Street  
 Jackson, Mississippi 39201

CODED

WATER WELL DRILLERS LOG  
 BUTANE GAS COMPANY

Leflore

7-31-78 19  
 date well completed

OF GREENWOOD

county well located


LANDOWNER:	description of formations encountered	from	to
William Tackett	Clay	0	36
Schlater (mailing address)	SAND	36	40
WELL LOCATION:	SAND + Peb GRAVEL	40	90
sec. 14 T 20 N R 2 E 3-3/4 miles SW of Schlater (distance) (direction) (nearest town)	SAND + GRAVEL	90	98
WELL PURPOSE: LAR (home, irrigation, municipal, industrial)	CODED		
WELL COMPLETION DATA:			
(1) diameter (inches) 16			
(2) total depth (feet) 98			
(3) static water level (feet) 25 below top of ground.			
(4) casing Steel 58 (material) (depth) 16 (size) if telescope see back.			
(5) screen 40 58 (length) (depth to top)			
(6) pump 16 Steel (size) (material)			
(6) pump 60 2800 (HP) (yield gpm)			
Diesel (type power)			
(7) electric log ND (yes or no)			
(organization running log)			
(8) how well bottom plugged Steel plate			
DRILLERS REMARKS:			

MISSISSIPPI  
 AUG - 9 1978

MISS. BD. OF WATER COMM

If well telescopes please sketch and show depths.

GROUND LEVEL

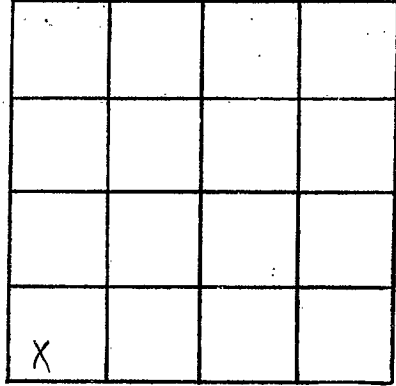

SECTION 14-

Please indicate well location X.

ADDITIONAL INFORMATION

If more than one screen,  
show locations of each on sketch.