

LEFLORE
 F 47
 5-21-79

MISSISSIPPI
 BOARD OF WATER COMMISSIONERS
 416 North State Street
 Jackson, Mississippi 39201

CODED

WATER WELL DRILLERS LOG
 BUTANE GAS COMPANY
 OF GREENWOOD
 firm name

Leflore
 county well located

5/21/79
 date well completed

LANDOWNER:
 Alvin Upchurch
 Itha BENA
 (mailing address)

description of formations encountered	from	to
CLAY	0	24
SAND	24	30
SAND + Pea Gravel	30	70
SAND + GRAVEL	70	97

WELL LOCATION:
 sec. 25 T 20 N R. 2 E
 S W
 5 miles NW of Itha BENA
 (distance) (direction) (nearest town)

WELL PURPOSE: IRR
 (home, irrigation, municipal, industrial)

WELL COMPLETION DATA:

(1) diameter (inches) 16"

(2) total depth (feet) 97

(3) static water level (feet) 20 below above top of ground.

(4) casing Steel, 57' (material) (depth)
 16" (size) if telescope see back.

(5) screen 40' , 57' (length) (depth to top)
 16" (size) , Steel (material)

(6) pump 60 (HP) 2500 (yield gpm)
 Diesel (type power)

(7) electric log NO (yes or no)

(organization running log)

(8) how well bottom plugged Steel Plate

Miss. Board of Water Commr.


111N - 8 1979

DRILLERS REMARKS:

RECEIVED

If well telescopes please sketch and show depths.

GROUND LEVEL

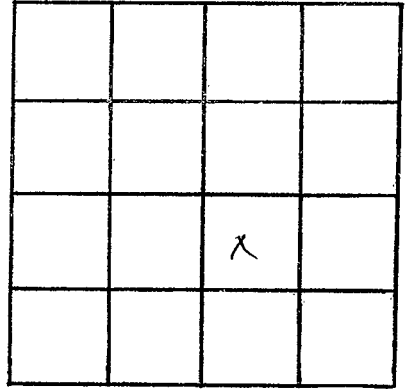

SECTION 25

Please indicate well location X.

ADDITIONAL INFORMATION

If more than one screen, show locations of each on sketch.