

LEFLORE
E-48
3-21-80

MISSISSIPPI
 BOARD OF WATER COMMISSIONERS
 416 North State Street
 Jackson, Mississippi 39201

CODED

WATER WELL DRILLERS LOG
BUTANE GAS COMPANY

3-21-80 19 OF GREENWOOD Leflore
 date well completed firm name county well located

LANDOWNER:	description of formations encountered	from	to
<u>D. N. STRAIN</u>			
<u>ITTA BENA</u> (mailing address)	<u>CLAY</u> <u>SAND & GRAVEL</u>	<u>0</u>	<u>30</u> <u>100</u>

WELL LOCATION:
 sec 33 T 20 N R 2E
 S W
5 1/2 miles NW of ITTA BENA
 (distance) (direction) (nearest town)

CODED

WELL PURPOSE: IRR
 (home, irrigation, municipal, industrial)

- WELL COMPLETION DATA:**
- (1) diameter (inches) 16
 - (2) total depth (feet) 100
 - (3) static water level (feet) 18 below above top of ground.
 - (4) casing Steel, 60
 (material), (depth)
16"
 (size) If telescope see back.
 - (5) screen 40', 60
 (length), (depth to top)
16", Steel
 (size), (material)
 - (6) pump 60 2500
 (HP) (yield gpm)
Diesel
 (type power)
 - (7) electric log No
 (yes or no)
 (organization running log)
 - (8) how well bottom plugged Steel Plate

DEPT. OF NATURAL RESOURCES
 BUREAU OF LAND & WATER RESOURCES


MAR 27 1980

RECEIVED

DRILLERS REMARKS:

If well telescopes please sketch and show depths.

GROUND LEVEL

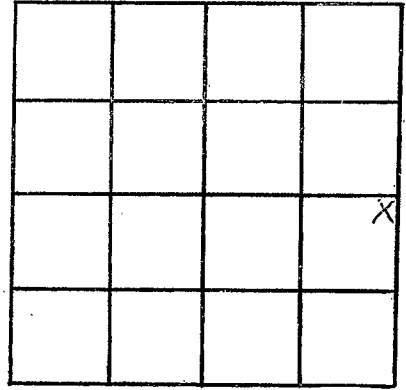

SECTION 33

Please indicate well location X.

ADDITIONAL INFORMATION

If more than one screen, show locations of each on sketch.