

LEFLORE  
F 53  
3/24/78

MISSISSIPPI  
BOARD OF WATER COMMISSIONERS  
416 North State Street  
Jackson, Mississippi 39201

CODED

WATER WELL DRILLERS LOG

BUTANE

Leflore

3/24/78  
date well completed

OF GREENWOOD

county well located

LANDOWNER:	description of formations encountered	from	to
William Tackett Schlater (mailing address)			
WELL LOCATION:			
sec. 18 T 20 N R 2 E S W			
5 miles SW of Schlater (distance) (direction) (nearest town)			
WELL PURPOSE: IRR (home, irrigation, municipal, industrial)			
WELL COMPLETION DATA:			
(1) diameter (inches) 16			
(2) total depth (feet) 100			
(3) static water level (feet) 18 below top of ground.			
(4) casing Steel 60 (material) (depth) 16" if telescope see back. (size)			
(5) screen 40 60 (length) (depth to top) 16" Steel (size) (material)			
(6) pump 60 3000 (HP) (yield gpm) Diesel (type power)			
(7) electric log No (yes or no)			
(organization running log)			
(8) how well bottom plugged Steel plate			
DRILLERS REMARKS:			


RECEIVED

MAR 30 1978

MISS. BD. OF WATER COMM.

If well telescopes please sketch and show depths.

GROUND LEVEL

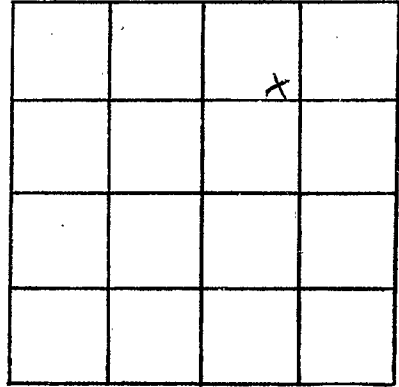

SECTION 12

Please indicate well location X.

ADDITIONAL INFORMATION

If more than one screen,  
show locations of each on sketch.