

LEFLORE

F54

3/28/78

3/28/78

date well completed

MISSISSIPPI
 BOARD OF WATER COMMISSIONERS
 416 North State Street
 Jackson, Mississippi 39201

CODED

WATER WELL DRILLERS LOG
 BUTANE GAS COMPANY

OF GREENWOOD

LeFlore

county well located

LANDOWNER:

C. R. Benz

Schlater

(mailing address)

description of formations encountered

from

to

Clay	0	20
Fine Sand	20	30
COARSE SAND	30	40
SAND & GRAVEL	40	100

CODED

WELL LOCATION:

sec. 14 T. 20 N. R. 2 E. W. 8

3 1/2 miles SW of Schlater (distance) (direction) (nearest town)

WELL PURPOSE: P.R. (home, irrigation, municipal, industrial)

WELL COMPLETION DATA:

- (1) diameter (inches) 16
- (2) total depth (feet) 100
- (3) static water level (feet) 18 below above top of ground.
- (4) casing Steel, 60 (material) (depth)
- 16 (size) if telescope see back.
- (5) screen 40 (length), 60 (depth to top)
- 16 (size), Steel (material)
- (6) pump 60 (HP), 2800 (yield gpm)
- Diesel (type power)
- (7) electric log NO (yes or no)

(organization running log)

(8) how well bottom plugged Steel Plate


DRILLERS REMARKS:

RECEIVED MAR 30 1978

MISS. BD. OF WATER COMM

If well telescopes please sketch and show depths.

GROUND LEVEL

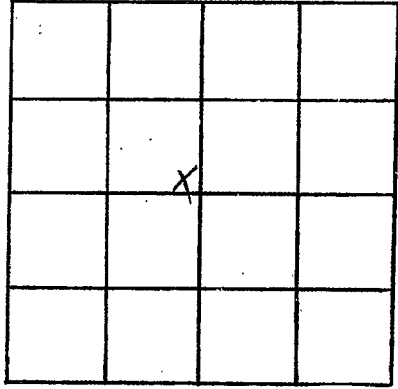

SECTION 14

Please indicate well location X.

ADDITIONAL INFORMATION

A series of horizontal lines for writing additional information.

If more than one screen, show locations of each on sketch.