

MISSISSIPPI DEPARTMENT OF NATURAL RESOURCES

Bureau of Land and Water Resources

Southport Mall

P.O. Box 10631

Jackson, Mississippi 39209

WATER WELL DRILLERS LOG

CODED

LEFLORE
F55
5-8-81

BUTANE GAS COMPANY

Leflore

5-8-81
date well completed

OF GREENWOOD
firm name

county well located

LANDOWNER:	description of formations encountered	from	to
<u>CONWAY FARMS</u>	<u>Clay</u>	<u>0</u>	<u>27</u>
<u>ITTA BENA</u>	<u>SAND</u>	<u>27</u>	<u>30</u>
(mailing address)	<u>SAND + Pea GRAVEL</u>	<u>30</u>	<u>44</u>
WELL LOCATION:	<u>WOOD (Tree)</u>	<u>44</u>	<u>48</u>
sec. <u>8</u> T. <u>20</u> N. R. <u>2</u> E. W. <u>5</u>	<u>SAND + Pea GRAVEL</u>	<u>48</u>	<u>70</u>
<u>5</u> miles <u>SW</u> of <u>Shiloh</u>	<u>SAND + GRAVEL</u>	<u>70</u>	<u>90</u>
(distance) (direction) (nearest town)			
WELL PURPOSE: <u>DR</u> (home, irrigation, municipal, industrial)			
WELL COMPLETION DATA:			
(1) diameter (inches) <u>16</u> "			
(2) total depth (feet) <u>90</u>			
(3) static water level (feet) <u>25</u> below top of ground.			
(4) casing <u>Steel</u> , <u>50</u> , (material) (depth)			
<u>16</u> (size) If telescope see back.			
(5) screen <u>40</u> , <u>50</u> " (length) (depth to top)			
<u>16</u> , <u>Steel</u> (size) (material)			
(6) pump <u>60</u> <u>2500</u> (HP) (yield gpm)			
<u>Diesel</u> (type power)			
(7) electric log <u>No</u> (yes or no)			
(organization running log)			
(8) how well bottom plugged <u>Steel Plate</u>			
DRILLERS REMARKS:			

CODED


DEPT. OF NATURAL RESOURCES
BUREAU OF LAND & WATER RESOURCES

MAY 12 1981

RECEIVED

If well telescopes please sketch and show depths.

GROUND LEVEL

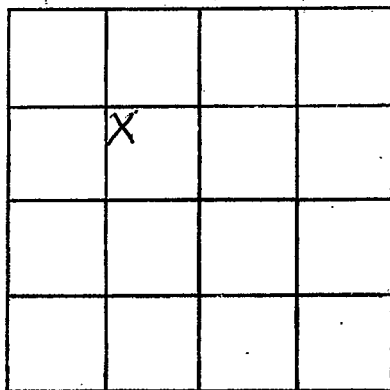

SECTION 8

Please indicate well location X.

ADDITIONAL INFORMATION

If more than one screen,
show locations of each on sketch.