

MISSISSIPPI DEPARTMENT OF NATURAL RESOURCES  
 Bureau of Land and Water Resources  
 Southport Mall  
 P.O. Box 10631  
 Jackson, Mississippi 39209  
**WATER WELL DRILLERS LOG**

**CODED**

Leflore  
F 58  
9-5-80

09/05 1980 Larry's well & Pump Leflore  
 date well completed      firm name      county well located

LANDOWNER: William Tackett  
Schlater, MS  
 (mailing address)

description of formations encountered	from	to
<u>slay</u>	<u>0</u>	<u>30</u>
<u>red. Sand</u>	<u>30</u>	<u>40</u>
<u>coarse sand</u>	<u>40</u>	<u>60</u>
<u>coarse sand &amp; gravel</u>	<u>60</u>	<u>110</u>

WELL LOCATION:  
 sec. 19 T. 20 N. R. 2 E  
6 miles NE of BIAINE  
 (distance) (direction) (nearest town)

**CODED**

WELL PURPOSE: Fish Pond  
 (home, irrigation, municipal, industrial)

- WELL COMPLETION DATA:
- diameter (inches) 16"
  - total depth (feet) 110'
  - static water level (feet) 26 <sup>below</sup> ~~above~~ top of ground.
  - casing steel (material), 70' (depth)  
 \_\_\_\_\_ if telescope see back.  
 (size)
  - screen 40' (length), 70' (depth to top)  
16" (size), steel (material)
  - pump 60 (HP), 3 (yield gpm)  
 \_\_\_\_\_ (type power)
  - electric log NO (yes or no)  
 \_\_\_\_\_ (organization running log)
  - how well bottom plugged Steel Plate

DRILLERS REMARKS: \_\_\_\_\_


DEPT. OF NATURAL RESOURCES  
 BUREAU OF LAND & WATER RESOURCES

MAY 18 1981

**RECEIVED**

If well telescopes please sketch and show depths.

GROUND LEVEL

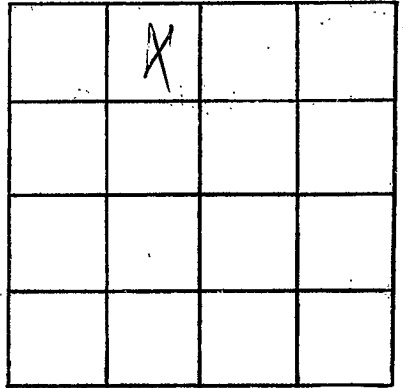

SECTION 19

Please indicate well location X.

ADDITIONAL INFORMATION

If more than one screen, show locations of each on sketch.