

MISSISSIPPI DEPARTMENT OF NATURAL RESOURCES

Bureau of Land and Water Resources

Southport Mall

P.O. Box 10631

Jackson, Mississippi 39209

WATER WELL DRILLERS LOG

CODED

LEFLORE
F59
4-26-81

BUTANE GAS COMPANY

LeFlore

4-26-81 19 date well completed


OF GREENWOOD

county well located

LANDOWNER:	description of formations encountered	from	to
Derwood STRAWN	Clay	0	20
MORGAN City (mailing address)	Soft Blue Clay	20	33
WELL LOCATION:	Fine Sand	33	40
sec. <u>35</u> T <u>20</u> N R <u>2</u> E S W	Sand + Gravel	40	98
6 miles NW of ITHAENA (distance) (direction) (nearest town)	Rock		
WELL PURPOSE: FRR. (home, irrigation, municipal, industrial)	CODED		
WELL COMPLETION DATA:			
(1) diameter (inches) <u>16"</u>			
(2) total depth (feet) <u>98</u>			
(3) static water level (feet) <u>30</u> below top of ground.			
(4) casing <u>Steel</u> , <u>58'</u> (material), (depth) <u>16"</u> if telescope see back. (size)			
(5) screen <u>40'</u> , <u>58'</u> (length), (depth to top)			
<u>16"</u> , <u>Steel</u> (size), (material)			
(6) pump <u>600</u> , <u>2500</u> (HP), (yield gpm)			
(type power)			
(7) electric log _____ (yes or no)			
(organization running log)			
(8) how well bottom plugged _____ <u>Steel Plate</u>			
DRILLERS REMARKS:			

If well telescopes please sketch and show depths.

GROUND LEVEL

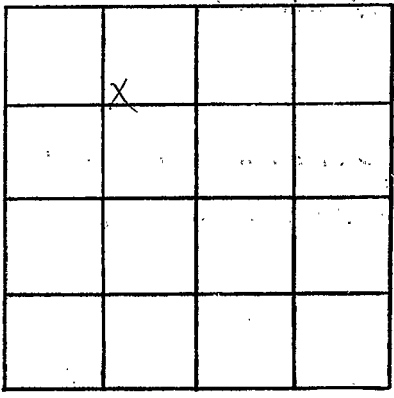

SECTION 35

Please indicate well location X.

ADDITIONAL INFORMATION

Multiple horizontal lines for additional information.

If more than one screen, show locations of each on sketch.