


MISSISSIPPI DEPARTMENT OF NATURAL RESOURCES
Bureau of Land and Water Resources
 Southport Mall
 P.O. Box 10631
 Jackson, Mississippi 39209
WATER WELL DRILLERS LOG

CODED

Leflore
F60
9/12/80


09/12 1980 Larrys well & Pump Leflore
 date/well completed firm name county/well located

LANDOWNER: <u>William Jackett</u>	description of formations encountered	from	to
<u>Schalter, MS</u> (mailing address)	<u>CLAY</u>	<u>0</u>	<u>24</u>
	<u>FINE SAND</u>	<u>24</u>	<u>50</u>
	<u>COURSE SAND & GRAVEL</u>	<u>50</u>	<u>106</u>
WELL LOCATION: sec. <u>19 T. 22 N.</u> R. <u>2 E.</u> <u>6</u> miles <u>E</u> of <u>BIWINE</u> (distance) (direction) (nearest town)			
WELL PURPOSE: <u>feet pump</u> (home, irrigation, municipal, industrial)			
WELL COMPLETION DATA:			
(1) diameter (inches) <u>16"</u>			
(2) total depth (feet) <u>106'</u>			
(3) static water level (feet) <u>25</u> <u>below</u> / <u>above</u> top of ground.			
(4) casing <u>Steel</u> / <u>66'</u> (material) (depth)			
(size) if telescope see back.			
(5) screen <u>40'</u> / <u>66'</u> (length) (depth to top)			
<u>16"</u> / <u>Steel</u> (size) (material)			
(6) pump <u>60</u> / <u>3000</u> (HP) (yield gpm)			
(type power)			
(7) electric log <u>NO</u> (yes or no)			
(organization running log)			
(8) how well bottom plugged <u>steel</u> <u>plate</u>			
DRILLERS REMARKS:			

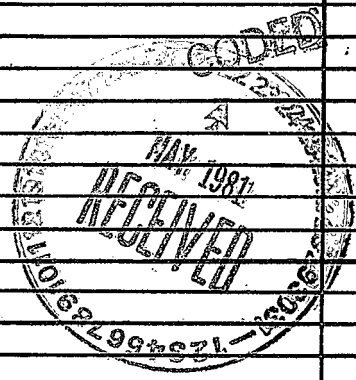

If well telescopes please sketch and show depths.

GROUND LEVEL

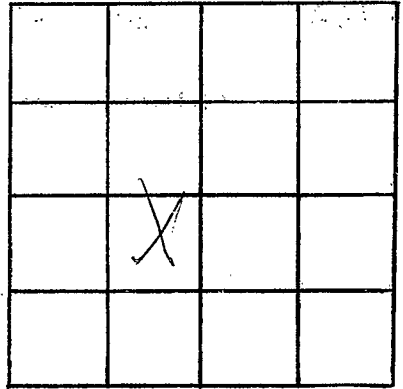

SECTION 19

Please indicate well location X.

ADDITIONAL INFORMATION

If more than one screen,
show locations of each on sketch.