

MISSISSIPPI DEPARTMENT OF NATURAL RESOURCES

Bureau of Land and Water Resources

Southport Mall

P.O. Box 10631

Jackson, Mississippi 39209

WATER WELL DRILLERS LOG

CODED

LeFlone
F61
9/11/80

09/11 1980
date well completed

1980

Larry's Well & Pump
firm name

LeFlone
county well located

LANDOWNER: William Tackett

description of formations encountered

from

to

Schlater, ms
(mailing address)

CLAY	0	30
FINE SAND	30	50
COARSE SAND GRAVEL	50	105

WELL LOCATION:


sec. 19 T. 20N R. 2 E
6 miles E of BLAINE
(distance) (direction) (nearest town)

CODED

WELL PURPOSE: Fish Pond
(home, irrigation, municipal, industrial)

WELL COMPLETION DATA:

- diameter (inches) 16"
- total depth (feet) 105'
- static water level (feet) 25' below top of ground.
- casing steel, 65'
(material) (depth)
(size) if telescope see back.
- screen 40' 65'
(length) (depth to top)
16" steel
(size) (material)
- pump 60 3000
(HP) (yield gpm)
(type power)
- electric log No.
(yes or no)

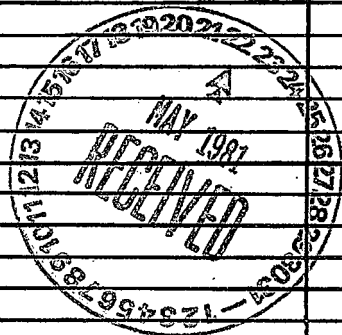


(organization running log)

(8) how well bottom plugged steel plate

DRILLERS REMARKS:

If well telescopes please sketch and show depths.

GROUND LEVEL

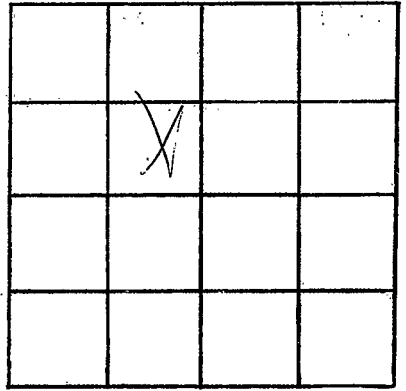

SECTION 19

Please indicate well location X.

ADDITIONAL INFORMATION

If more than one screen,
show locations of each on sketch.