

MISSISSIPPI DEPARTMENT OF NATURAL RESOURCES  
 Bureau of Land and Water Resources  
 Southport Mall  
 P.O. Box 10631  
 Jackson, Mississippi 39209  
**WATER WELL DRILLERS LOG**

**CODED**

*Lefflore*  
*F62*  
*3-2-81*

*3/2* 19 *81* *Dyer* *Lefflore*  
 date well completed firm name county well located

LANDOWNER:  
*ALLEN MIZE*  
*Itta Bena, MS.*  
 (mailing address)


description of formations encountered	from	to
	<i>Clay</i>	<i>0</i>
<i>fine sand</i>	<i>20</i>	<i>35</i>
<i>sand</i>	<i>35</i>	<i>88</i>
<i>sand + gravel</i>	<i>88</i>	<i>98</i>

WELL LOCATION:  
 sec. *35* *200* R. *2* E.  
*4* miles *NW* of *Itta Bena*  
 (distance) (direction) (nearest town)


WELL PURPOSE:  
 (home, irrigation, municipal, industrial)

**CODED**

WELL COMPLETION DATA:  
 (1) diameter (inches) *16"*  
 (2) total depth (feet) *98'*  
 (3) static water level (feet) *20'* below above top of ground.  
 (4) casing *steel* *98'*  
 (material) (depth)  
*16"* If telescope see back.  
 (size)  
 (5) screen *40'* *58'*  
 (length) (depth to top)  
*16"* *steel*  
 (size) (material)  
 (6) pump *60* *3000*  
 (HP) (yield gpm)  
*electric*  
 (type power)  
 (7) electric log (yes or no)  
 (organization running log)  
 (8) how well bottom plugged *plate*

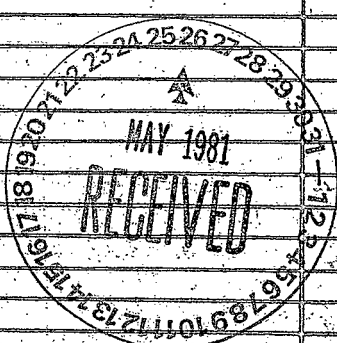

DRILLERS REMARKS:

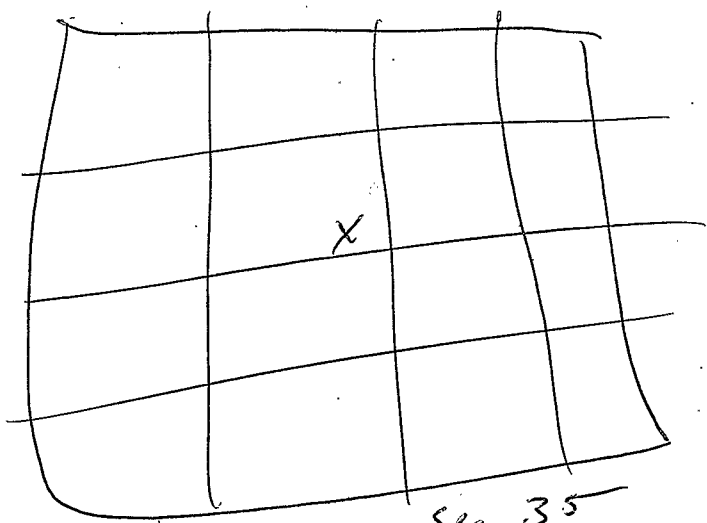

See 35