

Leflore
F 64
8-21-81

MISSISSIPPI DEPARTMENT OF NATURAL RESOURCES
Bureau of Land and Water Resources
Southport Mall
P.O. Box 10631
Jackson, Mississippi 39206
WATER WELL DRILLERS LOG

CODED 13

8-21-81 19 DYER WELL IN LEFLORE
date well completed firm name county well located

LANDOWNER:
BARGER FARM
(mailing address)

WELL LOCATION:
sec. 26 T 20 N R 2 E S
5 miles S of Sclater
(distance) (direction) (nearest town)

WELL PURPOSE:
(home, irrigation, municipal, industrial)

WELL COMPLETION DATA:

(1) diameter (inches) 16"
(2) total depth (feet) 100'
(3) static water level (feet) 21' below top of ground.
(4) casing Steel 60' (material) (depth)
16" (size) If telescope see back.
(5) screen 40' 60' (length) (depth to top)
16" Steel (size) (material)
(6) pump 60 3000 (HP) (yield gpm)
electric (type power)
(7) electric log no (yes or no)
(organization running log)
(8) how well bottom plugged plate

description of fomations encountered	from	to
Clay	0	18
fine sand	18	28
sand	28	38
sand & gravel	38	100

CODED

DEPT. OF NATURAL RESOURCES
BUREAU OF LAND & WATER RESOURCES


SEP 16 1981

RECEIVED

DRILLERS REMARKS:

If well telescopes please sketch and show depths.

GROUND LEVEL

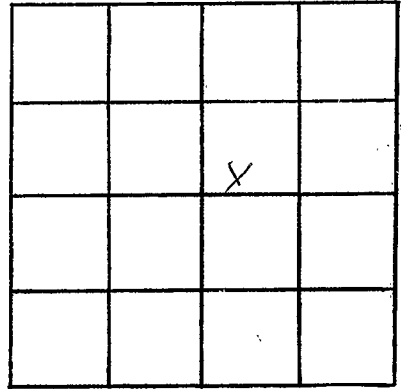

SECTION 26

Please indicate well location X.

ADDITIONAL INFORMATION

If more than one screen,
show locations of each on sketch.