

Leflore
F 65
9-8-81

MISSISSIPPI DEPARTMENT OF NATURAL RESOURCES
Bureau of Land and Water Resources
Southport Mall
P.O. Box 10631
Jackson, Mississippi 39209
WATER WELL DRILLERS LOG

CODED

9-8-81 19 DYER WELL LEFLORE
date well completed firm name county well located

LANDOWNER:
BARBER FARMS
GREENWOOD, MS.
(mailing address)

description of formations encountered	from	to
<u>Clay</u>	<u>0</u>	<u>40</u>
<u>Sand</u>	<u>40</u>	<u>54</u>
<u>Sand + Gravel</u>	<u>54</u>	<u>102</u>

WELL LOCATION:
sec. 26 T 20 N R 2 E
S W
6 miles NW of ITTA BENA
(distance) (direction) (nearest town)

WELL PURPOSE:
(home, irrigation, municipal, industrial)

WELL COMPLETION DATA:

(1) diameter (inches) 16"

(2) total depth (feet) 102'

(3) static water level (feet) 22' below top of ground.

(4) casing Steel, 62',
(material) (depth)
16" if telescope see back.
(size)

(5) screen 40', 62'
(length) (depth to top)
16", Steel
(size) (material)

(6) pump 60 3000
(HP) (yield gpm)
electric
(type power)

(7) electric log no
(yes or no)
plate
(organization running log)

(8) how well bottom plugged plate

CODED

DEPT. OF NATURAL RESOURCES
BUREAU OF LAND & WATER RESOURCES


OCT - 1 1981

RECEIVED

DRILLERS REMARKS:

If well telescopes please sketch and show depths.

GROUND LEVEL

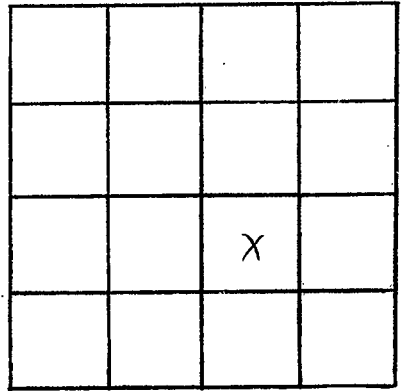

SECTION 26

Please indicate well location X.

ADDITIONAL INFORMATION

If more than one screen,
show locations of each on sketch.