

MISSISSIPPI DEPARTMENT OF NATURAL RESOURCES

Bureau of Land and Water Resources

Southport Mall

P.O. Box 10631

Jackson, Mississippi 39209

WATER WELL DRILLERS LOG

CODED

Jefferson
F 67
7-22-81

GW 3423

July 22 1981 Larry's well & Pump Jefferson
 Date well completed firm name County well located

LANDOWNER: <u>Reese Milliard</u>	description of formations encountered	from	to
<u>Schlater, Ms.</u> (mailing address)	<u>CLAY</u>	<u>0</u>	<u>50</u>
WELL LOCATION: sec. <u>32</u> T. <u>20</u> N R. <u>2</u> W <u>7</u> miles <u>SW</u> of <u>Schlater</u> (distance) (direction) (nearest town)	<u>FINE SAND</u>	<u>50</u>	<u>40</u>
WELL PURPOSE: <u>Fish Pond</u> (home, irrigation, municipal, industrial)	<u>COARSE SAND</u>	<u>70</u>	<u>14</u>
WELL COMPLETION DATA: (1) diameter (inches) <u>16"</u>			
(2) total depth (feet) <u>114'</u>			
(3) static water level (feet) <u>27</u> below above top of ground.			
(4) casing <u>Steel</u> , <u>74'</u> (material) (depth) (size) if telescope see back.			
(5) screen <u>40'</u> , <u>74'</u> (length) (depth to top) <u>16"</u> , <u>Steel</u> (size) (material)			
(6) pump <u>60</u> , <u>3000</u> (HP) (yield gpm) (type power)			
(7) electric log <u>NO</u> (yes or no) (organization running log)			
(8) how well bottom plugged <u>Steel Plate</u>			
DRILLERS REMARKS:			

CODED

DEPT. OF NATURAL RESOURCES
 BUREAU OF LAND & WATER RESOURCES


00719 1981

RECEIVED

If well telescopes please sketch and show depths.

GROUND LEVEL

3423
11021
11022
11256

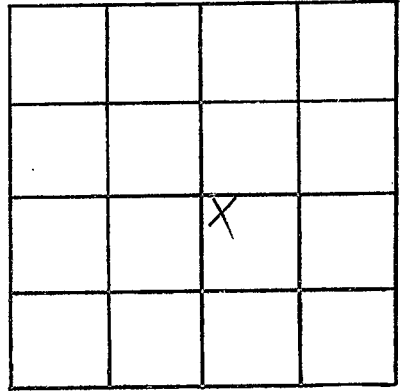

SECTION 32

Please indicate well location X.

ADDITIONAL INFORMATION

If more than one screen,
show locations of each on sketch.