

MISSISSIPPI DEPARTMENT OF NATURAL RESOURCES

Bureau of Land and Water Resources

Southport Mall

P.O. Box 10631

Jackson, Mississippi 39209

WATER WELL DRILLERS LOG

CODED

LEFLORE
F68
8/12/83

August 12, 1983 Dyer Well + Irrigation hoflore
date well completed firm name county well located

LANDOWNER: Hobbs Estate c/o W.G. Mize Greenwood, Miss. (mailing address)	description of formations encountered	from	to
	Clay	0	30
	Thin Sand	30	45
	Sand + Gravel	45	70
	Thin Sand	70	90
	Sand + Gravel	90	118
WELL LOCATION: sec. 31 T. 20N R. 2E S W 5 miles N of Ida Bend (distance) (direction) (nearest town)			
WELL PURPOSE: Irrigation (home, irrigation, municipal, industrial)			
WELL COMPLETION DATA: (1) diameter (inches) 16 (2) total depth (feet) 111 (3) static water level (feet) 25' below above top of ground. (4) casing Steel 74' (material) (depth) 16" if telescope see back. (size) (5) screen 40' 74' (length) (depth to top) 16" Mild Steel (size) (material) (6) pump 50 2,400 (HP) (yield gpm) Electric (type power) (7) electric log No (yes or no) (organization running log) (8) how well bottom plugged Plate			
DRILLERS REMARKS:			

CODED


DEPT. OF NATURAL RESOURCES
BUREAU OF LAND & WATER RESOURCES

DEC - 7 1983

RECEIVED

If well telescopes please sketch and show depths.

GROUND LEVEL

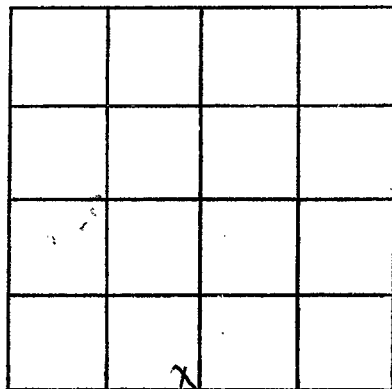

SECTION W1

Please indicate well location X.

ADDITIONAL INFORMATION

If more than one screen,
show locations of each on sketch.