

MISSISSIPPI DEPARTMENT OF NATURAL RESOURCES

Bureau of Land and Water Resources

Southport Mall

P.O. Box 10631

Jackson, Mississippi 39209

WATER WELL DRILLERS LOG

LEFLORE
F69

RECORDED
LEFLORE

10-17 1985
date well completed

BUTANE GAS COMPANY

county well located

OF GREENWOOD

LANDOWNER:
D.H. Strain

(mailing address)

WELL LOCATION:
sec. 35 T 20 N R 2 E
S W
6 miles NW of Atabera
(distance) (direction) (nearest town)

WELL PURPOSE:
(home, irrigation, municipal, industrial)

WELL COMPLETION DATA:

(1) diameter (inches) 4" x 2"

(2) total depth (feet) 1162

(3) static water level (feet) 27-137 below top of ground. above

(4) casing Steel 4"-987' 4"-126'
(material) (depth)
2" x 4" if telescope see back.
(size)

(5) screen 30' 1113
(length) (depth to top)

2" Steel
(size) (material)

(6) pump 1 22
(HP) (yield gpm)

Elect.
(type power)

(7) electric log No
(yes or no)
No
(organization running log)

description of formations encountered	from	to
CLAY	0	18
SAND	18	65
gravel	65	90
Gravel rock st.	90	115
SAND	115	160
gravel	160	175
land clay	175	205
CLAY	205	260
SAND	260	320
SAND rock - shale	320	355
Gummy shale	355	560
shale rock	560	580
sand	580	655
sand rock shale st.	655	780
shale	780	820
Sandy shale	820	875
hard shale	875	920
hard shale rock st.	920	960
sand shale	960	1085
sand	1085	1115
sand	1115	1158
sand shale	1158	1162

RECEIVED

NOV 15 1985


(8) how well bottom plugged
Back wash Valve

DRILLERS REMARKS:
Richard Vest

Department of Natural Resources
Bureau of Land & Water Resources

If well telescopes please
sketch and show depths.

GROUND LEVEL

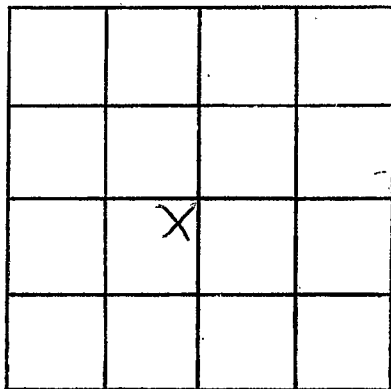

SECTION 31

Please indicate well location X.

ADDITIONAL INFORMATION

If more than one screen,
show locations of each on sketch.