

MISSISSIPPI DEPARTMENT OF NATURAL RESOURCES

Bureau of Land and Water Resources

Southport Mall

P.O. Box 10631

Jackson, Mississippi 39209

WATER WELL DRILLERS LOG

CODED

~~Survey~~
LEFLORE
F 70

8-4-86 19
date well completed

Ray Pumpwell Inc
firm name

LEFLORE
SOUTHWELLER
county well located

LANDOWNER: Tackett, James

Description of formations encountered

from

to

Rt. 1, Box 186

Schlater, Miss
(mailing address) 38952

clay	0	35
FINE SAND	35	55
COARSE SAND / PEAGRAVEL	55	105

WELL LOCATION:


sec. 17 T 20 N R 2 E
S 7 miles SW of Lettice
(distance) (direction) (nearest town)

WELL PURPOSE: fuel tank
(home, irrigation, municipal, industrial)

CODED

WELL COMPLETION DATA:

- (1) diameter (inches) 16
- (2) total depth (feet) 105
- (3) static water level (feet) _____ below/above top of ground.
- (4) casing STEEL 65'
(material) (depth)
16" if telescope see back.
(size)
- (5) screen 40 65'
(length) (depth to top)
16" STEEL
(size) (material)
- (6) pump 60 3000
(HP) (yield gpm)
- (7) electric log No
(yes or no)

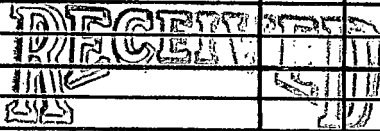

AUG 26 1986

(organization running log) STEEL

(8) how well bottom plugged PLATE


Department of Natural Resources
Bureau of Land & Water Resources

DRILLERS REMARKS:

Tackett

If well telescopes please sketch and show depths.

GROUND LEVEL

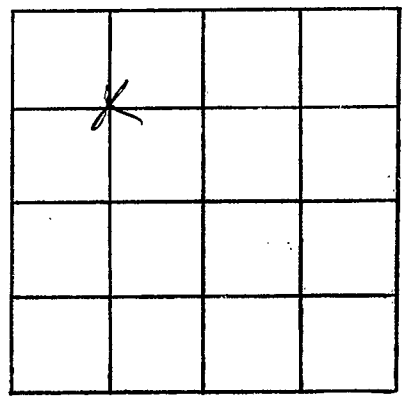

SECTION _____

Please indicate well location X.

ADDITIONAL INFORMATION

Lined area for additional information.

If more than one screen, show locations of each on sketch.