

MISSISSIPPI DEPARTMENT OF NATURAL RESOURCES

Bureau of Land and Water Resources

Southport Mall

P.O. Box 10631

Jackson, Mississippi 39209

CODED

WATER WELL DRILLERS LOG

NEFLORE
F 71
9-86

Powell

Deflore

date well completed

firm name

county well located

LANDOWNER:
Confidential

Memphis Jr
(mailing address)

description of formations encountered	from	to
<i>Clay</i>	<i>0</i>	<i>23</i>
<i>fine sand</i>	<i>23</i>	<i>43</i>
<i>coarse sand</i>	<i>43</i>	<i>113</i>
<i>gravel</i>		

WELL LOCATION:

sec *20* T *20* N R *2* W

6 miles *NE* of *Stapleton*
(distance) (direction) (nearest town)

CODED

WELL PURPOSE: *serv*
(home, irrigation, municipal, industrial)

WELL COMPLETION DATA:

(1) diameter (inches) *16*

(2) total depth (feet) *113*

(3) static water level (feet) *24* below above top of ground.

(4) casing *steel*, *73*,
(material) (depth)
(size) if telescope see back.

(5) screen *40*, *73*
(length) (depth to top)
16, *steel*
(size) (material)

(6) pump *60*, *2200*
(HP) (yield gpm)
Electric
(type power)

(7) electric log *NO*
(yes or no)

(organization running log)

(8) how well bottom plugged *steel plate*

RECEIVED


OCT 27 1986

Department of Natural Resources
Bureau of Land & Water Resources

DRILLERS REMARKS:
86149UG5-03

If well telescopes please sketch and show depths.

GROUND LEVEL

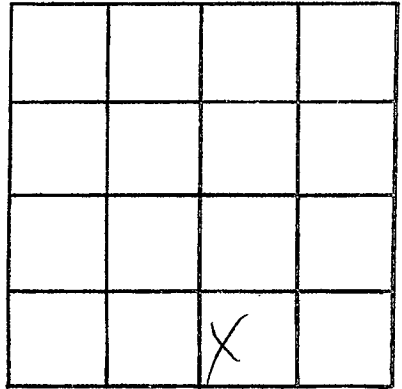

SECTION 20

Please indicate well location X.

ADDITIONAL INFORMATION

If more than one screen,
show locations of each on sketch.