

MISSISSIPPI DEPARTMENT OF NATURAL RESOURCES

Bureau of Land and Water Resources

Southport Mall

P.O. Box 10631

CODED

Jackson, Mississippi 39209

WATER WELL DRILLERS LOG

LEFLORE
F 72
9-86

19 1986 date well completed Bowell & Register Before firm name Jefferson county well located

LANDOWNER: Student's (Mrs)
Memphis Jr
 (mailing/address)

description of formations encountered	from	to
Clay	0	23
fine sand	23	43
Coarse sand + gravel	43	113

WELL LOCATION:
 sec 20 T 20 N R 2 W
6 miles NE of Shiloh
 (distance) (direction) (nearest town)

WELL PURPOSE: drw
 (home, irrigation, municipal, industrial)

WELL COMPLETION DATA:

(1) diameter (inches) 16

(2) total depth (feet) 113

(3) static water level (feet) 24 below above top of ground.

(4) casing steel 73
 (material) (depth)
 (size) if telescope see back.

(5) screen 40 73
 (length) (depth to top)
16 steel
 (size) (material)

(6) pump 60 2200
 (HP) (yield gpm)
Electric
 (type power)

(7) electric log No
 (yes or no)
 (organization running log)

(8) how well bottom plugged steel plate


RECEIVED
 OCT 27 1986

Department of Natural Resources
 Bureau of Land & Water Resources

DRILLERS REMARKS:
86149 MGS-04

If well telescopes please sketch and show depths.

GROUND LEVEL

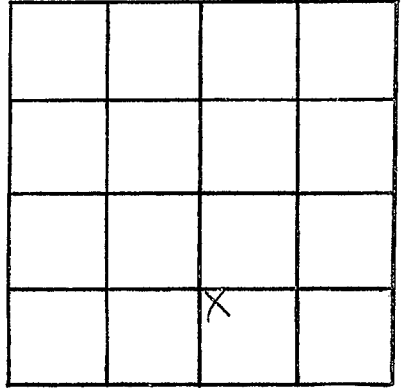

SECTION 20

Please indicate well location X.

ADDITIONAL INFORMATION

If more than one screen,
show locations of each on sketch.