

MISSISSIPPI DEPARTMENT OF NATURAL RESOURCES

Bureau of Land and Water Resources

Southport Mall

P.O. Box 10631

CODED

Jackson, Mississippi 39209

WATER WELL DRILLERS LOG

Powell *Before*

LEFLORE
F 73
9-86

date well completed

firm name

county well located

LANDOWNER:
Prudential Ins
Memphis, Jr
(mailing address)

description of formations encountered	from to	
<i>Clay</i>	<i>0</i>	<i>23</i>
<i>Fire clay shale</i>	<i>33</i>	<i>53</i>
<i>Coarse sand</i>	<i>53</i>	<i>113</i>

WELL LOCATION:
sec *19* T *29* N R *2* E
6 miles *NE* of *Shiloh*
(distance) (direction) (nearest town)

WELL PURPOSE: *drill*
(home, irrigation, municipal, industrial)

WELL COMPLETION DATA:

(1) diameter (inches) *16*

(2) total depth (feet) *113*

(3) static water level (feet) *24* below above top of ground.

(4) casing *steel* *73*
(material) (depth)
(size) if telescope see back.

(5) screen *40* *73*
(length) (depth to top)
16 *steel*
(size) (material)

(6) pump *60* *2200*
(HP) (yield gpm)
Electric
(type power)

(7) electric log *No*
(yes or no)
(organization running log)

(8) how well bottom plugged *steel plate*

RECEIVED


OCT 27 1986

Department of Natural Resources
Bureau of Land & Water Resources

DRILLERS REMARKS:
86149 MG-5-06

If well telescopes please sketch and show depths.

GROUND LEVEL

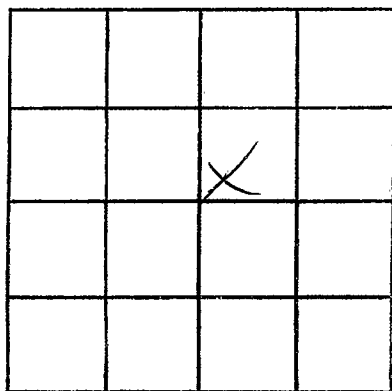

SECTION 19

Please indicate well location X.

ADDITIONAL INFORMATION

If more than one screen,
show locations of each on sketch.