

MISSISSIPPI DEPARTMENT OF NATURAL RESOURCES

Bureau of Land and Water Resources

Southport Mall

P.O. Box 10631

Jackson, Mississippi 39209

WATER WELL DRILLERS LOG

LEFLORE
F 74

19 Powell Leffre
 date well completed firm name county well located

LANDOWNER: Prudential
Memphis, Jr
 (mailing address)

description of formations encountered	from	to
<u>Clay</u>	<u>0</u>	<u>13</u>
<u>fine sand</u>	<u>13</u>	<u>53</u>
<u>coarse sand</u>	<u>53</u>	<u>105</u>
<u>+ gravel</u>		

WELL LOCATION:
 sec. 19 T. 20 N. R. 2 E.
6 miles NE of Sunflower
 (distance) (direction) (nearest town)

WELL PURPOSE: drw
 (home, irrigation, municipal, industrial)

WELL COMPLETION DATA:

(1) diameter (inches) 12

(2) total depth (feet) 105

(3) static water level (feet) 24 below above top of ground.


(4) casing steel, 65,
 (material) (depth)
 (size) If telescope see back.

(5) screen 40 65
 (length) (depth to top)
12, steel
 (size) (material)

(6) pump 50 1800
 (HP) (yield gpm)
Electric
 (type power)

(7) electric log no
 (yes or no)
 (organization running log)

(8) how well bottom plugged steel plate

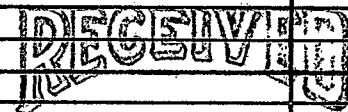


OCT 27 1986

Department of Natural Resources
 Bureau of Land & Water Resources

DRILLERS REMARKS:
replace old well

If well telescopes please sketch and show depths.

GROUND LEVEL

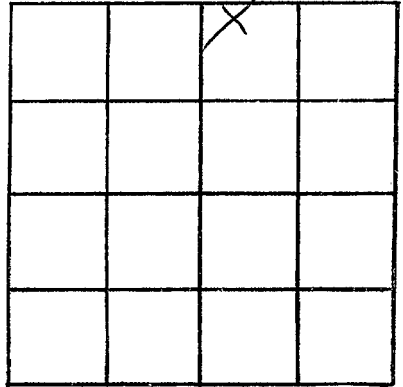

SECTION 19

Please indicate well location X.

ADDITIONAL INFORMATION

If more than one screen,
show locations of each on sketch.